

MONROE  
0 2015  
9-67

MISSISSIPPI BOARD OF WATER COMMISSIONERS

WATER WELL DRILLERS LOG

Herndon-Homan Well & Supply, Inc.

Date: 9-1, 1967, Driller: P. O. Box 42, County Monroe  
(When well drilled) SHANNON, MISSISSIPPI 38801 (Where well is located)

(1) Owner of Land:	Description & Color of Materials	Thick-ness Feet	Depth Feet
Sterling Waddell (Name)	surface sand &		
Prairie Mississippi (Address)	clay	0	20
(2) Location: NE 1/4, NW 1/4, Sec. 18, T15R1E	Blue clay	20	280
2 miles SE of Prairie (distance) (direction) (Nearest Town)	Sand	280	400
Bottom		400	
(3) Topography: flat (Hilly) (Flat) (Level)			
(4) Purpose of Well: Domestic (Domestic Irrigation, Municipal, Industrial, Other)			

Information upon completion of well:

- (1) Diameter 5 inches.
- (2) Total Depth 400 feet.
- (3) Water Level 145' feet below top of ground.
- (4) Cased to 221, Size 54
- (5) Screen: Size NONE, Length \_\_\_\_\_
- (6) Were any formations sealed against pollution?  
 yes,  no.

If YES depth of formation 18


Why surface & sand

Drillers Remarks:

Yield in gpm: 5

Size pump: 1/2 HP Sub.

Type power: electric

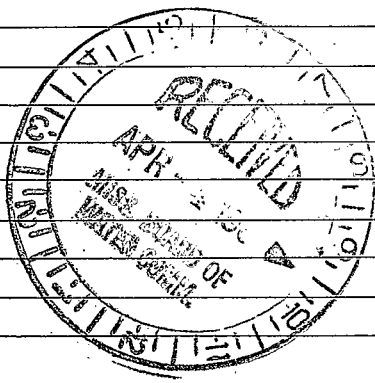




