MISSISSIPPI DEPARTMENT OF NATURAL RESOURCES

Bureau of Land and Water Resources

P.O. Box 10631
Jackson, Mississippi 39209

WATER WELL DRILLERS LOG

COUNTY WELL LOCATED: Monroe

WELL NUMBER: P 2031 | CODED:

PERMIT NUMBER:

NAME OF DRILLING FIRM: Herndon Well & Supply

Shannon, MS 38868

DATE WELL COMPLETED: 04/05/89

NAME & MAILING ADDRESS OF LANDOWNER:

Joe Jolly

548 Churchill Rd.

West Point

WELL LOCATION: SEC 14 TOWNSHIP 16 [N] S RANGE 7 [E]

DISTANCE 10 Miles DIRECTION South of NEAREST TOWN Aberdeen

OTHER LANDMARK:

WELL PURPOSE: Home, Irrigation, Municipal, Industrial, Fish Pond, etc.: Home

PUMP DATA

PUMP TYPE (Circle One): (Submersible,) Turbine, Jet Flowing Well, Other (Describe) 1/2hp

POWER TYPE (Circle One): (Electric,) Tractor, Diesel, Gasoline, Butane, Other (Describe)

Pump Capacity (GPM)	No. of Stages	Setting Depth
5	5	160 FT.

PUMP TEST

Well yielded _____ GPM with a drawdown of _____ ft. after _____ hours of pumping

WELL DATA

Well Depth	Casing Diameter (In.)	Casing Length (Ft.)
290'	4"	280'

Type of Casing	Hole Depth	Depth to Static Water Level
PVC	294'	117'

TYPE OF COMPLETION: (Circle One or More): (Gravel Packed,) Underreamed, Telescoped, Natural Development, Open Hole, Other (Describe)

Top of Lap Pipe or Reduction in Casing

FEET

IF TELESCOPED OR MORE THAN ONE SCREEN: USE BACK PAGE

SCREEN DATA

Diameter - Inches	Length - Feet	Slot Size - Inches
4"	10'	.010

Screen Type	Depth to Bottom - Feet
PVC	290'

LOG DATA

TYPE OF LOG RUN (Circle One): (No Log Run,) Electric, Gamma Ray, Density, Sonic, Neutron, Other (Describe)

Name of Organization Running Log

GEOLOGIC DATA (Office Use Only)

Surface Elev.	Geologic Unit	Unit Thickness	Depth to Top
Subs. SWL	Date	Analysis	Aquifer Test

Driller's Remarks

DESCRIPTION OF FORMATIONS ENCOUNTERED	FROM	TO
Red Clay	0	10
Red Sand	10	38
Blue Clay & Sand	38	80
Clay, Streaks of Sand	80	112
Rock	112	113
Clay	113	210
Rock	210	211½
Clay & Sand	211½	270
Sand	270	290
Clay	290	294

FORMATIONS (Continued)

FROM	TO

RECEIVED
APR 10 1989
Department of Natural Resources
Bureau of Land & Water Resources

IF MORE SPACE IS NEEDED, USE BACK

If well telescopes please sketch and show depths.

GROUND LEVEL

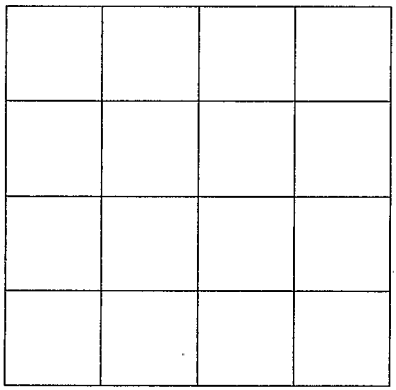

SECTION _____

Please indicate well location X.

ADDITIONAL INFORMATION

If more than one screen, show location of each on sketch.