

CODED

Q 55

WATER WELL DRILLERS LOG

7-19-62

Date: 7-19, 1962, Driller: J.C. REEVES County MONROE

768-13 869-12 870-4 1292-11 455 (Name) ON LEFT where 45 FOLKS

- (1) Owner of Land: J.A. COCKERHAM
(Name)
HAMILTON, MISS.
(Address)
- (2) Location: SW NE SW 1/4, Sec. 32 T.15 R.18,
1 miles SOUTH of HAMILTON
(distance) (direction) (Nearest Town)
- (3) Topography: LEVEL
(Hilly) (Flat) (Level)
- (4) Purpose of Well: DOM.
(Domestic Irrigation
Municipal, Industrial, Other)

Description & Color of Materials Sand, Clay, Red Clay, Shell, etc.	Thick- ness Feet	Depth Feet
<u>CLAY</u>	<u>14</u>	<u>0</u>
<u>RED SAND</u>	<u>9</u>	<u>14</u>
<u>BLUE CLAY</u>	<u>4</u>	<u>23</u>
<u>BLUESAND (SLOPPY)</u>	<u>9</u>	<u>27</u>
<u>BLUE CLAY</u>	<u>22</u>	<u>36</u>
<u>" SAND</u>	<u>32</u>	<u>58</u>


Information upon completion of well:

- (1) Diameter 4 inches.
- (2) Total Depth 90 feet.
- (3) Water Level 16 feet below top of ground.
- (4) Cased to 39', Size 4"
- (5) Screen: Size —, Length —
- (6) Were any formations sealed against pollution?
— yes, — no.

If YES depth of formation _____
Why _____

Drillers Remarks: _____

CODED

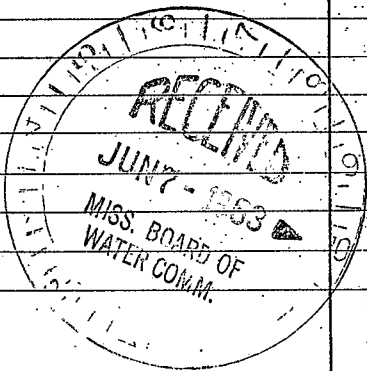

(Use Back Side)

Well No.


