MISSISSIPPI DEPARTMENT OF NATURAL RESOURCES

Bureau of Land and Water Resources

P.O. Box 10631
Jackson, Mississippi 39209
WATER WELL DRILLERS LOG

COUNTY WELL LOCATED: Monroe	
WELL NUMBER: 9	CODED: 2021
DATE WELL COMPLETED: 12-15-87	
PERMIT NUMBER: N/A	
NAME OF DRILLING FIRM: Herndon Well & Supply, Shannon, Ms.	

NAME & MAILING ADDRESS OF LANDOWNER:
Linda Murphee
Rt. 4 Box 244
Aberdeen, Ms.

WELL LOCATION: SEC 35 TOWNSHIP T15 N/S RANGE R8 E/W

DISTANCE 5 Miles DIRECTION SOUTH of NEAREST TOWN Aberdeen

OTHER LANDMARK

WELL PURPOSE: Home, Irrigation, Municipal, Industrial, Fish Pond, etc.
369-6177 home 325-8046 work

PUMP DATA

PUMP TYPE (Circle One): Submersible, Turbine, Jet, Flowing Well, Other (Describe)

POWER TYPE (Circle One): Electric, Tractor, Diesel, Gasoline, Butane, Other (Describe)

Pump Capacity (GPM)	No. of Stages	Setting Depth
5	9	147' FT.

PUMP TEST

Well yielded _____ GPM with a drawdown of _____ ft. after _____ hours of pumping

WELL DATA

Well Depth	Casing Diameter (In.)	Casing Length (Ft.)
170	4"	160

Type of Casing	Hole Depth	Depth to Static Water Level
PVC	180	124'

TYPE OF COMPLETION: (Circle One or More): Gravel Packed, Underreamed, Telescoped, Natural Development, Open Hole, Other (Describe)

Top of Lap Pipe or Reduction in Casing: FEET

IF TELESCOPED OR MORE THAN ONE SCREEN: USE BACK PAGE

LOG DATA

TYPE OF LOG RUN (Circle One): No Log Run, Electric, Gamma Ray, Density, Sonic, Neutron, Other (Describe)

Name of Organization Running Log

GEOLOGIC DATA (Office Use Only)

Surface Elev.	Geologic Unit	Unit Thickness	Depth to Top
Subs. SWL	Date	Analysis	Aquifer Test

Driller's Remarks

SCREEN DATA

Diameter - Inches	Length - Feet	Slot Size - Inches
4"	10'	.016

Screen Type	Depth to Bottom - Feet
PVC	170

DESCRIPTION OF FORMATIONS ENCOUNTERED	FROM	TO
White clay	0	18
white sand	18	30
tight blue sand	30	118
rock	118	119
tight blue sand	119	134
rock	134	135
sand & clay	135	170
tight blue sand	170	180

FORMATIONS (Continued)	FROM	TO

IF MORE SPACE IS NEEDED, USE BACK

RECEIVED DEC 18 1987 Department of Natural Resources Bureau of Land & Water Resources

If well telescopes please
sketch and show depths.

GROUND LEVEL

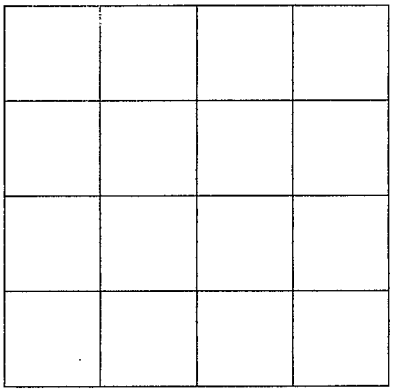

SECTION _____

Please indicate well location X.

ADDITIONAL INFORMATION

If more than one screen,
show location of each on sketch.