MISSISSIPPI DEPARTMENT OF ENVIRONMENTAL QUALITY
Office of Land and Water Resources

P. O. Box 10631
Jackson, MS 39289-0631
WATER WELL DRILLERS LOG

COUNTY WELL LOCATED: Monroe	PERMIT NUMBER:
WELL NUMBER: 9 / CODED: 2028	NAME OF DRILLING FIRM: Clardy Well
DATE WELL COMPLETED: 1/12/00	Columbus, MS.

NAME & MAILING ADDRESS OF LANDOWNER: Apac, P.O. Box 1388, Columbus, MS 39701

WELL LOCATION: SEC 9 TOWNSHIP 15 N (S) RANGE 18 E (W)

DISTANCE 9 Miles DIRECTION SE of NEAREST TOWN Aberdeen

OTHER LANDMARK:

WELL PURPOSE: Home, Irrigation, Municipal, Industrial, Fish Pond, etc.: Industrial

PUMP DATA

PUMP TYPE (Circle One): (Submersible) Turbine, Jet, Flowing Well, Other (Describe)

POWER TYPE (Circle One): (Electric) Tractor, Diesel, Gasoline, Butane, Other (Describe) H/P 1

Pump Capacity (GPM)	No. of Stages	Setting Depth
15	12	100 FT.

PUMP TEST

Well yielded _____ GPM with a drawdown of _____ ft. after _____ hours of pumping

WELL DATA

Well Depth	Casing Diameter (In.)	Casing Length (Ft.)
222	4"	123'
Type of Casing	**Hole Depth**	**Depth to Static Water Level**
Steel		35'

TYPE OF COMPLETION: (Circle One or More): Gravel Packed, Underreamed, Telescoped, Natural Development, Open Hole, Other (Describe)

WELL GROUTED TO A DEPTH OF _____ FEET
Type Grout (circle one): Cement, Bentonite, or Mix

LOG DATA

TYPE OF LOG RUN (Circle One): No Log Run, Electric, Gamma Ray, Density, Sonic, Neutron, Other (Describe)

Name of Organization Running Log

GEOLOGIC DATA (Office Use Only)

Surface Elev.	Geologic Unit	Unit Thickness	Depth to Top
Subs. SWL	Date	Analysis	Aquifer Test

Driller's Remarks

SCREEN DATA

Diameter - Inches	Length - Feet	Slot Size - Inches
2"	40'	.013
Screen Type		**Depth to Bottom - Feet**
PVC		

DESCRIPTION OF FORMATIONS ENCOUNTERED	FROM	TO	FORMATIONS (Continued)	FROM	TO
Red sandy clay	0	7			
Sand & gravel	7	37			
Blue clay	37	149			
Rocky sand streak	149	151			
Sandy clay	151	182			
Rocky sand	182	222			
			IF MORE SPACE IS NEEDED, USE BACK		

If well telescopes please
sketch and show depths.

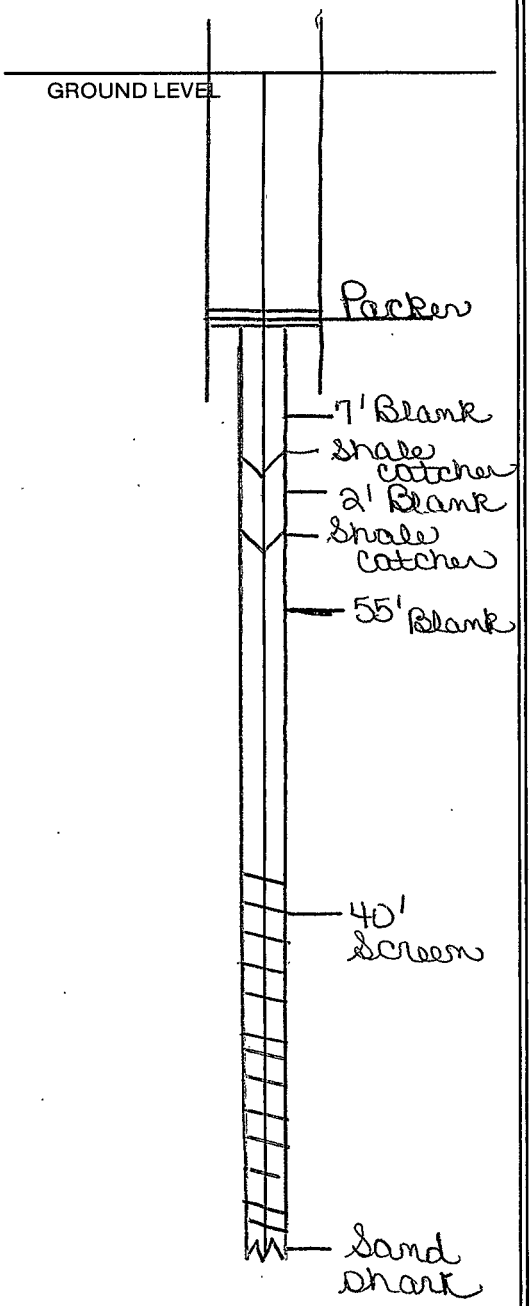

If more than one screen,
show location of each on sketch.

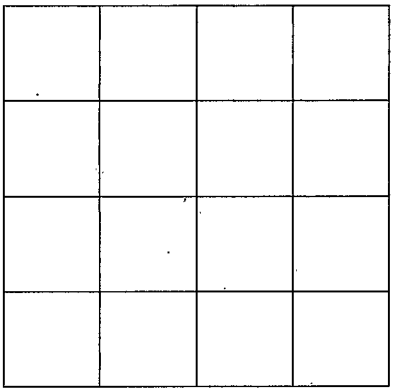

SECTION _____

Please indicate well location X.

ADDITIONAL INFORMATION