Monroe
R 2009

5/12/81

MISSISSIPPI
BOARD OF WATER COMMISSIONERS
416 North State Street
Jackson, Mississippi 39201

WATER WELL DRILLERS LOG

5-12 1981 Martin S. Kirkpatrick Monroe
date well completed — firm name — county well located

LANDOWNER: W.S. HORSTMAN
Ph-601-369-6005
Aberdeen MS.
(mailing address)

WELL LOCATION:
sec. 2 T. 15 N/S R. 19 E/W
6 miles NE of Hamilton
(distance) (direction) (nearest town)

WELL PURPOSE: Home
(home, irrigation, municipal, industrial)

WELL COMPLETION DATA:

(1) diameter (inches) 4
(2) total depth (feet) 122
(3) static water level (feet) _____ below/above top of ground.
(4) casing P.V.C. (material), 122 (depth), _____ (size) if telescope see back.
(5) screen 20 (length), 102 (depth to top)
4 (size), P.V.C. (material)
(6) pump 1/2 (HP) 10 (yield gpm)
E. (type power)
(7) electric log _____ (yes or no)
_____ (organization running log)
(8) how well bottom plugged

DRILLERS REMARKS: mesh valve in bottom & Gravel packed.

description of formations encountered	from	to
Red Clay	0	30
Sdy Clay	30	95
Sand & Gravel	95	122

DEPT. OF NATURAL RESOURCES
BUREAU OF LAND & WATER RESOURCES
MAY 18 1981
RECEIVED

If well telescopes please sketch and show depths.

GROUND LEVEL

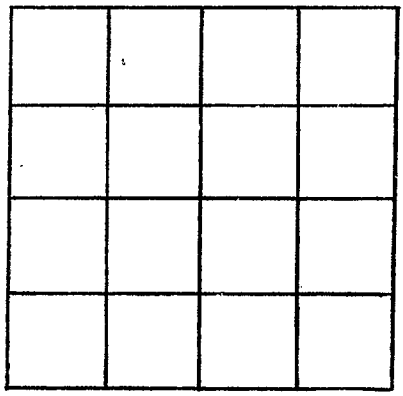

SECTION _____

Please indicate well location X.

ADDITIONAL INFORMATION

If more than one screen, show locations of each on sketch.