[redacted]

Montgomery
B 2000
2/11/77

150

MISSISSIPPI
BOARD OF WATER COMMISSIONERS
416 North State Street
Jackson, Mississippi 39201

WATER WELL DRILLERS LOG

Feb. 11 1977 Lipe Well Co. Montgomery
date well completed — firm name — county well located

LANDOWNER:
Ray Smith
Duck Hill Ms.
(mailing address)

WELL LOCATION:
sec. 35 T. 21 N/S R. 7 E/W
11 (distance) miles east (direction) of Duck Hill (nearest town)

WELL PURPOSE:
(home) irrigation, municipal, industrial)

WELL COMPLETION DATA:

(1) diameter (inches) 4
(2) total depth (feet) 300
(3) static water level (feet) 26 below above top of ground.
(4) casing PVC (material), 288 (depth),
4 (size) If telescope see back.
(5) screen 12 (length), 288 (depth to top)
4 (size), PVC (material)
(6) pump 1½ (HP) 25 (yield gpm)
elec (type power)
(7) electric log no (yes or no)
ND (organization running log)
(8) how well bottom plugged PVC Cap

DRILLERS REMARKS:

description of formations encountered	from	to
Top Soil	0	20
Sand	20	40
Clay	40	60
"	60	160
Fine sand and clay	160	180
Clay	180	200
"	200	230
Sand	230	300

RECEIVED
FEB 22 1977
MISS. BD. OF WATER COMM

If well telescopes please sketch and show depths.

GROUND LEVEL

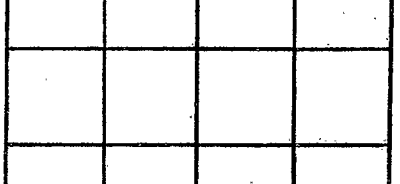

SECTION _____

Please indicate well location X.

ADDITIONAL INFORMATION

If more than one screen, show locations of each on sketch.