

NESHOBA

WATER WELL DRILLERS LOG

CODED

10-30-62

Date: 10-30 1962, Driller: P.B. Nicholas, County: Neshoba

PR-101 Lige Henry (Name)

(1) Owner of Land: U.S. Govt. Shila - Miss. (Name) (Address) 36 12 10

(2) Location: 1/4, 1/4, Sec. 1, R. 16 miles N-west of Shila (distance) (direction) (Nearest Town)

(3) Topography: Hilly (Hilly) (Flat) (Level)

(4) Purpose of Well: Domestic (Domestic Irrigation, Municipal, Industrial, Other)

Description & Color of Materials Sand, Clay, Red Clay, Shell, etc.	Thick- ness Feet	Depth Feet
Chalk & dirt	0	28
rock & shell	28	80
blue dirt & sand	80	115
water sand	115	127

Information upon completion of well:

(1) Diameter 3 7/8 inches.

(2) Total Depth 127 feet.

(3) Water Level 70 feet below top of ground.

(4) Cased to joint, Size 2"

(5) Screen: Size 2", Length 10ft


(6) Were any formations sealed against pollution? yes, no.

If YES depth of formation 11ft 4" pipe

Why Sanitary Purpos

Drillers Remarks: 4" casing set at 86 ft Electric Pump

CODED

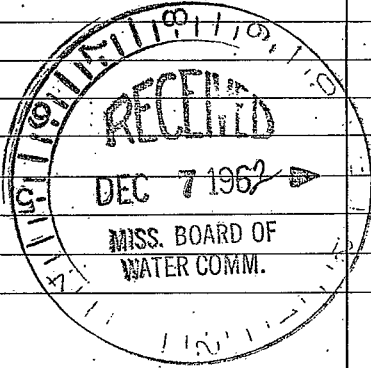

(Use Back Side)

Well No.

1892












