MISSISSIPPI DEPARTMENT OF NATURAL RESOURCES

Bureau of Land and Water Resources

P.O. Box 10631
Jackson, Mississippi 39209

WATER WELL DRILLERS LOG

COUNTY WELL LOCATED: Neshoba
WELL NUMBER: A 2015 CODED:
DATE WELL COMPLETED: 5-14-89

PERMIT NUMBER:
NAME OF DRILLING FIRM: Thomas Drilling
Carthage, MS

NAME & MAILING ADDRESS OF LANDOWNER:
J + B Farm
Rt. 8 Box 190
Carthage, MS 39051

WELL LOCATION: SEC 28 TOWNSHIP 12 (N) S RANGE 10 (E) W

DISTANCE: 3 Miles DIRECTION: S of NEAREST TOWN: Alice

OTHER LANDMARK: Church 1 mile West

WELL PURPOSE: Home, Irrigation, Municipal, Industrial, Fish Pond, etc.: Chicken House

PUMP DATA

PUMP TYPE (Circle One): Submersible, Turbine, (Jet), Flowing Well, Other (Describe) 1-H.P. Sta-Rite

POWER TYPE (Circle One): (Electric), Tractor, Diesel, Gasoline, Butane, Other (Describe) 220 Voltage

Pump Capacity (GPM)	No. of Stages	Setting Depth to Jet
7	2	60 FT.

PUMP TEST: Well yielded 7 GPM with a drawdown of 3 ft. after 1 hours of pumping

WELL DATA

Well Depth	Casing Diameter (In.)	Casing Length (Ft.)
510'	2"	490'

Type of Casing	Hole Depth	Depth to Static Water Level
PVC	570'	38'

TYPE OF COMPLETION: (Circle One or More): Gravel Packed, Underreamed, Telescoped, Natural Development, Open Hole, Other (Describe) Sand Packed

Top of Lap Pipe or Reduction in Casing: — FEET

IF TELESCOPED OR MORE THAN ONE SCREEN: USE BACK PAGE

LOG DATA

TYPE OF LOG RUN (Circle One): (No Log Run), Electric, Gamma Ray, Density, Sonic, Neutron, Other (Describe)

Name of Organization Running Log

GEOLOGIC DATA (Office Use Only)

Surface Elev.	Geologic Unit	Unit Thickness	Depth to Top
Subs. SWL	Date	Analysis	Aquifer Test

Driller's Remarks

SCREEN DATA

Diameter - Inches	Length - Feet	Slot Size - Inches
2"	20'	.10

Screen Type	Depth to Bottom - Feet
PVC wrapped	510'

DESCRIPTION OF FORMATIONS ENCOUNTERED	FROM	TO
Sand	0	40
Gray Chalk	40	150
Chalk with little Sand	150	235
Gray Chalk	235	265
Chalk with little Sand	265	278
Gray chalk	278	300
Lignite & Chalk	300	405
~~405~~ Fine Gray Sand	405	428
Gray Chalk	428	495
Course White Sand	495	510

FORMATIONS (Continued)

FROM	TO

IF MORE SPACE IS NEEDED, USE BACK

RECEIVED
JUL 21 1987
Department of Natural Resources
Bureau of Land & Water Resources

If well telescopes please sketch and show depths.

GROUND LEVEL

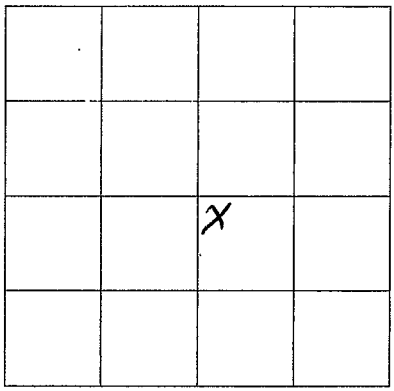

SECTION 28

Please indicate well location X.

ADDITIONAL INFORMATION

If more than one screen, show location of each on sketch.