THOMPSON
R
NESHOBA
C 2002

MISSISSIPPI DEPARTMENT OF NATURAL RESOURCES
Bureau of Land and Water Resources
Southport Mall
P.O. Box 10631
Jackson, Mississippi 39209
WATER WELL DRILLERS LOG

5-30 19 [illegible] Smith's well drilling Neshoba
date well completed — firm name — county well located

LANDOWNER: Thompson

(mailing address)

WELL LOCATION:
sec. 2 T 12(N) S R 12(E) W
14 miles [illegible] of [illegible]
(distance) (direction) (nearest town)

WELL PURPOSE: Farm
(home, irrigation, municipal, industrial)

WELL COMPLETION DATA:

(1) diameter (inches) 4
(2) total depth (feet) 175
(3) static water level (feet) 30 below/above top of ground.
(4) casing PVC (material), 145 (depth),
_____ (size) if telescope see back.
(5) screen 030 (length), 145 (depth to top)
4 (size), PVC (material)
(6) pump 1 (HP) 12 (yield gpm)
E (type power)
(7) electric log _____ (yes or no)
_____ (organization running log)
(8) how well bottom plugged [illegible]

DRILLERS REMARKS: _____

description of formations encountered	from	to
Red clay	0	15
clay & sand	15	175

RECEIVED
NOV 26 1990
Department of Natural Resources
Bureau of Land & Water Resources

If well telescopes please sketch and show depths.

GROUND LEVEL

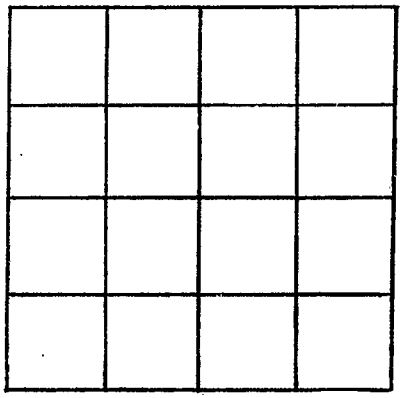

SECTION _____

Please indicate well location X.

ADDITIONAL INFORMATION

If more than one screen, show locations of each on sketch.