

E41

WATER WELL DRILLERS LOG

CODED

8-27-62

Date: 8-27, 1962, Driller: P. P. Nicholas County: Neshoba

PR-3 Hudson, Tubby (Name)

(1) Owner of Land: V.S. Gout
 Phila. Mick (Name)
 (Address) 25 11 10

(2) Location: 1/4, 1/4, Sec. T R
 6 1/2 miles West of Phila.
 (distance) (direction) (Nearest Town)

(3) Topography: Hilly
 (Hilly) (Flat) (Level)

(4) Purpose of Well: Domestic
 (Domestic Irrigation
 Municipal, Industrial, Other)

Description & Color of Materials Sand, Clay, Red Clay, Shell, etc.	Thick- ness Feet	Depth Feet
Clay & Chalk	1	2.5
Sand & Chalk	25	5.5
Water Sand	55	64

CODED

Information upon completion of well:

(1) Diameter 3 7/8 inches.

(2) Total Depth 64 feet.

(3) Water Level 48 feet below top of ground.

(4) Cased to Point, Size 7"


(5) Screen: Size 7", Length 5'

(6) Were any formations sealed against pollution?
 Yes, no.

If YES depth of formation 11 ft 4" Pipe

Why Sanitary Purpose

Drillers Remarks: Cylinder
 Set 58 ft

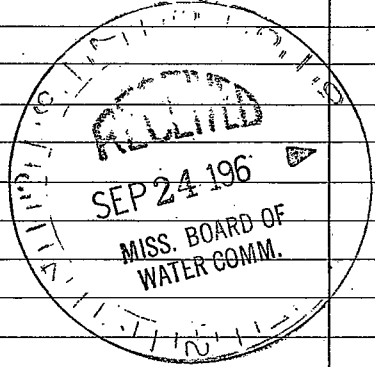

(Use Back Side)

Well No.





