

NESHOBIA

F43

WATER WELL DRILLERS LOG

CODED

8-3-62

Date: 8-3, 1962, Driller: R.R. Nicholson, County: Neshoba

PK 54 Arbin Company Name

(1) Owner of Land: U.S. Govt. (Name) Phila. Miss. (Address)

(2) Location: 30 1111 1/4, 1/4, Sec. T R. 6/2 miles West of Phila. (distance) (direction) (Nearest Town)

(3) Topography: Hilly (Hilly) (Flat) (Level)

(4) Purpose of Well: Domestic (Domestic Irrigation Municipal, Industrial, Other)

Description & Color of Materials Sand, Clay, Red Clay, Shell, etc. ...	Thick- ness Feet	Depth Feet
Pipe Clay	1	3
Clay Sand & Clay	3	19
Blue dirt	19	60
Black dirt	60	105
Mix. sand & Shell	105	126
water sand	126	147

CODED

Information upon completion of well:

(1) Diameter 3 7/8 inches.

(2) Total Depth 147 feet.

(3) Water Level 8.5 feet below top of ground.

(4) Cased to Joint, Size 2"


(5) Screen: Size 2", Length 10'

(6) Were any formations sealed against pollution? 1 yes, no.

If YES depth of formation 2 3 ft. 4" Pipe

Why Sanitary Purpose

Drillers Remarks: Cylinder Set 10 7'

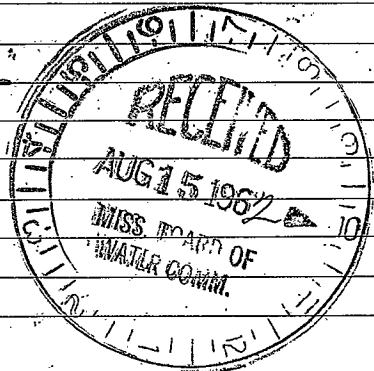

(Use Back Side)

Well No.














