Neshoba
6 36 CODED
6-68

MISSISSIPPI
BOARD OF WATER COMMISSIONERS
416 North State Street
Jackson, Mississippi 39201

WATER WELL DRILLERS LOG

June 21 1968 19 — date well completed
Beck Smith — firm name
Neshoba — county well located

LANDOWNER: J L Publes
Rt 3
Phila, Miss
(mailing address)

WELL LOCATION:
sec. 3 T 11 (N/S) R 12 (E/W)
4 (distance) miles E (direction) of PHILA (nearest town)

WELL PURPOSE: home
(home, irrigation, municipal, industrial)

WELL COMPLETION DATA:
(1) diameter (inches) 2"
(2) total depth (feet) 50'
(3) static water level (feet) 20 below/above top of ground.
(4) casing galv. (material), 45' (depth),
_____ (size) if telescope see back.
(5) screen 5' (length), 45' (depth to top)
8 (size), Stainless steel (material)
(6) pump 1/2 (HP) _____ (yield gpm)
elec. (type power)
(7) electric log NO (yes or no)
_____ (organization running log)
(8) how well bottom plugged back
wash value

DRILLERS REMARKS:

description of formations encountered	from	to
red clay	0	20
Gray sand	20	50

CODED

JUN 6 1968
MISS. BOARD OF WATER COMMISSIONERS

If well telescopes please sketch and show depths.

GROUND LEVEL

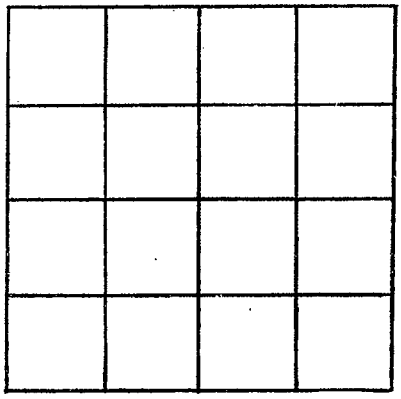

SECTION _____

Please indicate well location X.

ADDITIONAL INFORMATION

If more than one screen, show locations of each on sketch.