NESHOBA
G 2004

MISSISSIPPI DEPARTMENT OF NATURAL RESOURCES
Bureau of Land and Water Resources
Southport Mall
P.O. Box 10631
Jackson, Mississippi 39209

WATER WELL DRILLERS LOG

10 30 – 1988 Smith's Well Drilling Neshoba
date well completed — firm name — county well located

LANDOWNER: J.F. Turner

(mailing address)

WELL LOCATION:

sec. ___ T 11 N R 12 E

4 miles EAST of PHILA
(distance) (direction) (nearest town)

WELL PURPOSE: ___
(home, irrigation, municipal, industrial)

WELL COMPLETION DATA:

(1) diameter (inches) 4

(2) total depth (feet) 130

(3) static water level (feet) 30 (below / above) top of ground.

(4) casing PVC (material), 120 (depth),
___ (size) if telescope see back.

(5) screen 10 (length), 120 (depth to top)
4 (size), PVC (material)

(6) pump ½ (HP) 12 (yield gpm)
EGC (type power)

(7) electric log ___ (yes or no)
___ (organization running log)

(8) how well bottom plugged ___

DRILLERS REMARKS: ___

description of formations encountered	from	to
Sand		

RECEIVED
NOV 26 1988
Department of Natural Resources
Bureau of Land & Water Resources

If well telescopes please sketch and show depths.

GROUND LEVEL

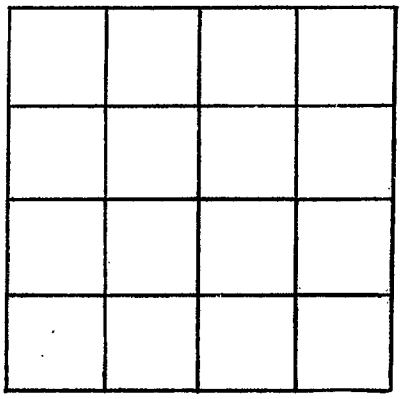

SECTION _____

Please indicate well location X.

ADDITIONAL INFORMATION

If more than one screen, show locations of each on sketch.