

K 9  
4-20-61

CODED 6 131

WATER WELL DRILLERS LOG

K 300

Date: 4 20, 1961, Driller: [Signature] County: [Signature]

(Name)


(1) Owner of Land:	Description & Color of Materials Sand, Clay, Red Clay, Shell, etc.	Thick- ness Feet	Depth Feet
<u>asa Young</u> (Name) <u>Trilake, Miss.</u> (Address)	<u>blue to grey</u> <u>clay shale</u>		<u>30</u>
(2) Location: <u>1/4</u> , <u>1/4</u> , Sec. <u>T</u> <u>R</u> <u>1</u> miles <u>south</u> of <u>Trilake</u> (distance) (direction) (Nearest Town)			<u>45</u>
(3) Topography: <u>[check]</u> (Hilly) (Flat) (Level)			
(4) Purpose of Well: <u>Hand used</u> (Domestic Irrigation Municipal, Industrial, Other)	<u>on H. V. 15 S</u> <u>7 miles south of</u> <u>Trilake, Miss.</u> <u>within north of</u> <u>1/4 1/4</u>		

Information upon completion of well:

- (1) Diameter 2 inches.
- (2) Total Depth 45 feet.
- (3) Water Level 30 feet below top of ground.
- (4) Cased to 40, Size 2 in
- (5) Screen: Size 1/2 in, Length 5 ft
- (6) Were any formations sealed against pollution?  
 \_\_\_\_\_ yes, [check] no.

If YES depth of formation \_\_\_\_\_  
 Why \_\_\_\_\_  
 Drillers Remarks: \_\_\_\_\_

CODED

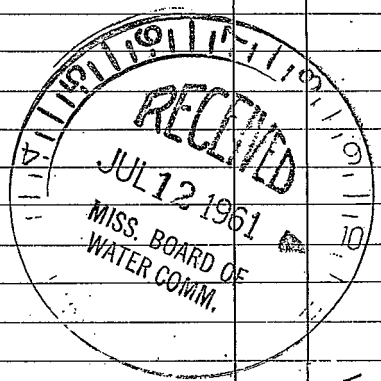

Well No.

(Use Back Side)










