MISSISSIPPI DEPARTMENT OF NATURAL RESOURCES

Bureau of Land and Water Resources

P.O. Box 10631
Jackson, Mississippi 39209
WATER WELL DRILLERS LOG

COUNTY WELL LOCATED: NESHOBA	
WELL NUMBER: D 2006	CODED
DATE WELL COMPLETED: 5-23-88	
PERMIT NUMBER: 0-474	
NAME OF DRILLING FIRM: GARDNER DRILLING	

NAME & MAILING ADDRESS OF LANDOWNER
L. O. DRISKEL
RT. 1 BOX 479
UNION, MS. 39365

WELL LOCATION: SEC 29 TOWNSHIP 9 N/S RANGE 11 E/W

DISTANCE 2 Miles DIRECTION W of NEAREST TOWN UNION

OTHER LANDMARK

WELL PURPOSE: Home, Irrigation, Municipal, Industrial, Fish Pond, etc.

PUMP DATA

PUMP TYPE (Circle One): Submersible, Turbine, Jet Flowing Well, Other (Describe) ____

POWER TYPE (Circle One): Electric, Tractor, Diesel, Gasoline, Butane, Other (Describe) ____

Pump Capacity (GPM)	No. of Stages	Setting Depth
12	10	135 FT.

PUMP TEST

Well yielded 12 GPM with a drawdown of 135 ft. after 1 hours of pumping

WELL DATA

Well Depth	Casing Diameter (In.)	Casing Length (Ft.)
180	4"	140'

Type of Casing	Hole Depth	Depth to Static Water Level
PVC	180	117'

TYPE OF COMPLETION: (Circle One or More): Gravel Packed, Underreamed, Telescoped, Natural Development, Open Hole, Other (Describe) ____

Top of Lap Pipe or Reduction in Casing FEET

IF TELESCOPED OR MORE THAN ONE SCREEN: USE BACK PAGE

LOG DATA

TYPE OF LOG RUN (Circle One): No Log Run, Electric, Gamma Ray, Density, Sonic, Neutron, Other (Describe) ____

Name of Organization Running Log: X

GEOLOGIC DATA (Office Use Only)

Surface Elev.	Geologic Unit	Unit Thickness	Depth to Top
Subs. SWL	Date	Analysis	Aquifer Test

Driller's Remarks

SCREEN DATA

Diameter - Inches	Length - Feet	Slot Size - Inches

Screen Type	Depth to Bottom - Feet

RECEIVED
JUN 16 1988
Department of Natural Resources
Bureau of Land & Water Resources

DESCRIPTION OF FORMATIONS ENCOUNTERED	FROM	TO
SAND	0	50
CLAY	50	90
CLAY + SHELL LEDGES	90	140

FORMATIONS (Continued)	FROM	TO

IF MORE SPACE IS NEEDED, USE BACK

If well telescopes please
sketch and show depths.

GROUND LEVEL

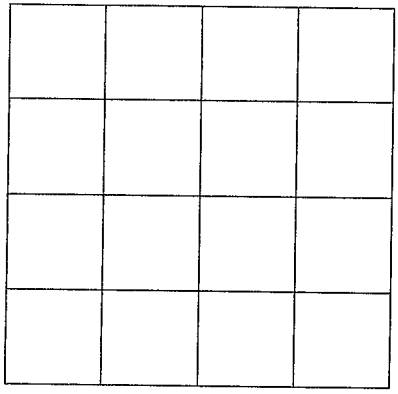

SECTION _____

Please indicate well location X.

ADDITIONAL INFORMATION

If more than one screen,
show location of each on sketch.