NESHOBA

COUNTY WELL LOCATED: NEWTON

WELL NUMBER: Ø 2007 | CODED:

DATE WELL COMPLETED: MAY 23, 1988

MISSISSIPPI DEPARTMENT OF NATURAL RESOURCES

Bureau of Land and Water Resources

P.O. Box 10631
Jackson, Mississippi 39209
WATER WELL DRILLERS LOG

PERMIT NUMBER:

NAME OF DRILLING FIRM: GARDNER DRILLING

NAME & MAILING ADDRESS OF LANDOWNER:
OZBORN DRISKOL
RT. 1 BOX 479
UNION, MS. 39365

WELL LOCATION: SEC 29 TOWNSHIP 9 N/S RANGE 11 E/W

DISTANCE 5 Miles DIRECTION W of NEAREST TOWN UNION

OTHER LANDMARK:

WELL PURPOSE: Home, Irrigation, Municipal, Industrial, Fish Pond, etc.

PUMP DATA

PUMP TYPE (Circle One): Submersible, Turbine, Jet, Flowing Well, Other (Describe)

POWER TYPE (Circle One): Electric, Tractor, Diesel, Gasoline, Butane, Other (Describe)

Pump Capacity (GPM)	No. of Stages	Setting Depth
12	7	160' FT.

PUMP TEST

Well yielded 12 GPM with a drawdown of 40' ft. after 2 hours of pumping

WELL DATA

Well Depth	Casing Diameter (In.)	Casing Length (Ft.)
180'	4"	140'

Type of Casing	Hole Depth	Depth to Static Water Level
PVC	180'	117'

TYPE OF COMPLETION: (Circle One or More): Gravel Packed, Underreamed, Telescoped, Natural Development, Open Hole, Other (Describe)

Top of Lap Pipe or Reduction in Casing: FEET

IF TELESCOPED OR MORE THAN ONE SCREEN: USE BACK PAGE

SCREEN DATA

Diameter - Inches	Length - Feet	Slot Size - Inches
—	—	—

Screen Type	Depth to Bottom - Feet
—	—

LOG DATA

TYPE OF LOG RUN (Circle One): No Log Run, Electric, Gamma Ray, Density, Sonic, Neutron, Other (Describe)

Name of Organization Running Log

GEOLOGIC DATA (Office Use Only)

Surface Elev.	Geologic Unit	Unit Thickness	Depth to Top
Subs. SWL	Date	Analysis	Aquifer Test

Driller's Remarks

RECEIVED FEB 9 1989 Department of Natural Resources Bureau of Land & Water Resources

DESCRIPTION OF FORMATIONS ENCOUNTERED	FROM	TO	FORMATIONS (Continued)	FROM	TO
CLAY	0	10			
SAND	10	65			
CLAY	65	145			
SHELL ROCK	145	155			
SAND	155	170			
ROCK	170	175			
SAND	175	180			
			IF MORE SPACE IS NEEDED, USE BACK		

If well telescopes please
sketch and show depths.

GROUND LEVEL

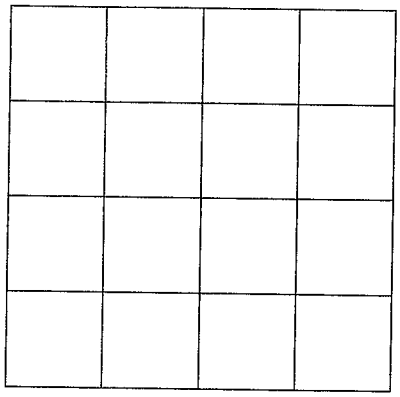

SECTION _____

Please indicate well location X.

ADDITIONAL INFORMATION

If more than one screen,
show location of each on sketch.