MISSISSIPPI DEPARTMENT OF ENVIRONMENTAL QUALITY
Office of Land and Water Resources

P. O. Box 10631
Jackson, MS 39289-0631
WATER WELL DRILLERS LOG

COUNTY WELL LOCATED	NESHOBA
WELL NUMBER	P 2007
CODED	
DATE WELL COMPLETED	9-21-00
PERMIT NUMBER	
NAME OF DRILLING FIRM	PARKS + PARK WELL SERVICE

NAME & MAILING ADDRESS OF LANDOWNER
HARDY SPEARS
304 Kent Ave.
Metairie La 70001

WELL LOCATION:	SEC	TOWNSHIP	RANGE
NE 1/4	10	19 (N) S	12 (E) W

DISTANCE	DIRECTION	NEAREST TOWN
Miles	of	

OTHER LANDMARK

WELL PURPOSE: Home, Irrigation, Municipal, Industrial, Fish Pond, etc.

PUMP DATA

PUMP TYPE (Circle One): Submersible, Turbine, Jet Flowing Well, Other (Describe)

POWER TYPE (Circle One): Electric, Tractor, Diesel, Gasoline, Butane, Other (Describe) H/P 1

Pump Capacity (GPM)	No. of Stages	Setting Depth
12		188 FT.

PUMP TEST

Well yielded _____ GPM with a drawdown of _____ ft. after _____ hours of pumping

WELL DATA

Well Depth	Casing Diameter (In.)	Casing Length (Ft.)
230	4	200

Type of Casing	Hole Depth	Depth to Static Water Level
PVC	240	

TYPE OF COMPLETION: (Circle One or More): Gravel Packed, Underreamed, Telescoped, Natural Development, Open Hole, Other (Describe)

WELL GROUTED TO A DEPTH OF _____ FEET
Type Grout (circle one): Cement, Bentonite, or Mix

LOG DATA

TYPE OF LOG RUN (Circle One): No Log Run, Electric, Gamma Ray, Density, Sonic, Neutron, Other (Describe)

Name of Organization Running Log

GEOLOGIC DATA (Office Use Only)

Surface Elev.	Geologic Unit	Unit Thickness	Depth to Top
Subs. SWL	Date	Analysis	Aquifer Test

Driller's Remarks

Top of Lap Pipe or Reduction in Casing
FEET

IF TELESCOPED OR MORE THAN ONE SCREEN: USE BACK PAGE

SCREEN DATA

Diameter - Inches	Length - Feet	Slot Size - Inches
4	30	.010

Screen Type	Depth to Bottom - Feet
PVC	230

DESCRIPTION OF FORMATIONS ENCOUNTERED	FROM	TO
Top Soil	0	5
CLAY	5	189
SAND	189	231
CLAY	231	240

FORMATIONS (Continued)	FROM	TO

IF MORE SPACE IS NEEDED, USE BACK

RECEIVED
JUN 1 8 2001
Dept. of Environmental Quality
Office of Land & Water Resources

If well telescopes please
sketch and show depths.

GROUND LEVEL

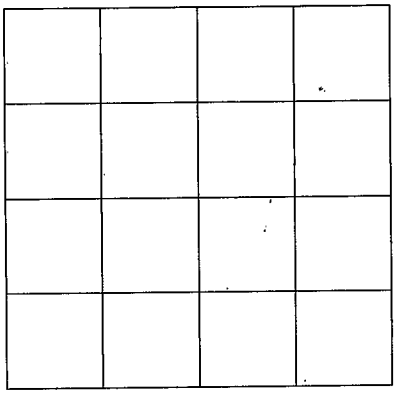

SECTION _____

Please indicate well location X.

ADDITIONAL INFORMATION

If more than one screen,
show location of each on sketch.