Neshoba
Q 18
12-22-69

CODED
CODED

MISSISSIPPI
BOARD OF WATER COMMISSIONERS
416 North State Street
Jackson, Mississippi 39201

WATER WELL DRILLERS LOG

12-22 1969 RBR Nicholson Neshoba
date well completed (firm name) county well located

LANDOWNER: Little Zion Church
Union
Union
(mailing address)

WELL LOCATION:
sec 13 T 9 N/S R 12 E/W
14 (distance) miles E (direction) of Union (nearest town)

WELL PURPOSE: Church
(home, irrigation, municipal, industrial)

WELL COMPLETION DATA:

(1) diameter (inches) 4 1/4
(2) total depth (feet) 46
(3) static water level (feet) 30 below above top of ground.
(4) casing Steel (material), 41 (depth),
7" (size) if telescope see back.
(5) screen 5 (length), 46 (depth to top)
1 1/4 (size), Steel (material)
(6) pump 1 (HP) 12 (yield gpm)
Elect (type power)
(7) electric log _____ (yes or no)
_____ (organization running log)
(8) how well bottom plugged _____

DRILLERS REMARKS: _____

description of formations encountered	from	to
Chalk & Clay	0	25
Blue Dirt	25	35
Water Sand	35	46

JAN 21 1970
MISS. BD. OF WATER COMM.

If well telescopes please sketch and show depths.

GROUND LEVEL

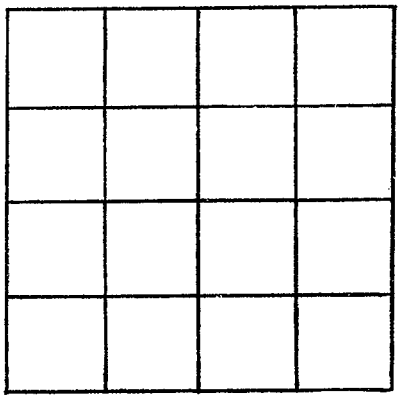

SECTION 13

Please indicate well location X.

ADDITIONAL INFORMATION

If more than one screen, show locations of each on sketch.