Neshoba
Q25
4-10-73

MISSISSIPPI
BOARD OF WATER COMMISSIONERS
416 North State Street
Jackson, Mississippi 39201

CODED

WATER WELL DRILLERS LOG

4-10 19 73 Lester Oglesby Neshoba
date well completed firm name county well located

LANDOWNER: Thomas Gibson
RFD 3
Union Miss
(mailing address)

WELL LOCATION:
sec. 4 T 9 (N) S R 13 (E) W
10 SE miles South of Philo.
(distance) (direction) (nearest town)

WELL PURPOSE:
(home) irrigation, municipal, industrial)

WELL COMPLETION DATA:

(1) diameter (inches) 3
(2) total depth (feet) 9
(3) static water level (feet) 70 below above top of ground.
(4) casing Galv. (material), 84 (depth),
2" (size) if telescope see back.
(5) screen 5 (length), 90 (depth to top),
1¼ (size), Stainless Steel (material)
(6) pump ¾ (HP) 7 (yield gpm)
R.E.A. (type power)
(7) electric log _____ (yes or no)
_____ (organization running log)
(8) how well bottom plugged BW

DRILLERS REMARKS: _____

description of formations encountered	from	to
Clay	0	18
Shale	18	32
Red Clay	32	49
Shale	49	79
Water Sand	79	90

CODED

If well telescopes please sketch and show depths.

Silly

GROUND LEVEL

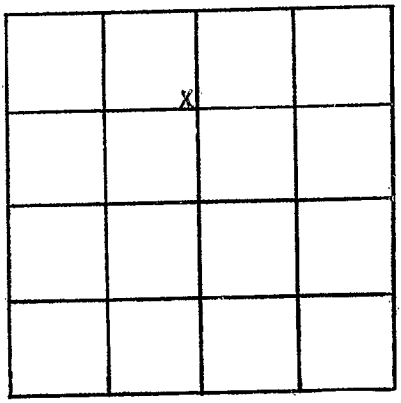

SECTION _____

Please indicate well location X.

ADDITIONAL INFORMATION

If more than one screen, show locations of each on sketch.