

A2

WATER WELL DRILLERS LOG

2-1-62

Date: 2-1, 1962, Driller: R.R. Nicholson County Newton

(Name)

(1) Owner of Land: Garland Gordon (Name)

Union Miss (Address)

Description & Color of Materials Sand, Clay, Red Clay, Shell, etc.

Thick-ness Feet

Depth Feet

Chalk & sand	1	30
Clay & sand	30	55
Water sand	55	69

(2) Location: 1/4, SE 1/4, Sec. 9 T. 8 N. R. 10 E

10 miles west of Union (distance) (direction) (Nearest Town)

(3) Topography: R (Hilly) (Flat) (Level)

(4) Purpose of Well: Domestic (Domestic Irrigation Municipal, Industrial, Other)

Information upon completion of well:

(1) Diameter 4 1/2 inches.

(2) Total Depth 69 feet.

(3) Water Level 48 feet below top of ground.

(4) Cased to Grout, Size 2'

(5) Screen: Size 1/2", Length 6 ft.


(6) Were any formations sealed against pollution?

yes, X no.

If YES depth of formation

Why

Drillers Remarks: Good case
gray water sand

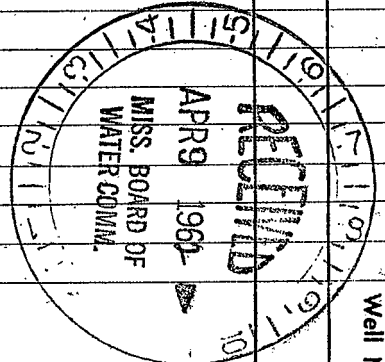

(Use Back Side)

Well No.




