NEWTON

A

2012

MISSISSIPPI
BOARD OF WATER COMMISSIONERS
416 North State Street
Jackson, Mississippi 39201

WATER WELL DRILLERS LOG

6-21-78 19 McDonald & Hill Newton

date well completed — firm name — county well located

LANDOWNER: W.L. Evans

Rt #2 Union

(mailing address)

WELL LOCATION:

sec. 18 T 8 N/S R 10 E/W

8 miles SW of Union

(distance) (direction) (nearest town)

WELL PURPOSE: home

(home, irrigation, municipal, industrial)

WELL COMPLETION DATA:

(1) diameter (inches) 4"

(2) total depth (feet) 240'

(3) static water level (feet) 70' below above top of ground.

(4) casing PVC (material), 170' (depth)

4" (size) If telescope see back.

(5) screen — (length), — (depth to top)

— (size), — (material)

(6) pump 1/2 (HP) 6 gpm (yield gpm)

E (type power)

(7) electric log — (yes or no)

(organization running log)

(8) how well bottom plugged open

DRILLERS REMARKS:

description of formations encountered	from	to
Clay & sand	0	14
lignite & clay	14	25
sand	25	85
sandy shale	85	105
shale	105	112
Rock & shell & sand	112	120
shale	120	175
Rock & shells	175	195
green sand & sandy shale	195	210
Rock & shale & sand	210	240

RECEIVED JUN 23 1978 OF WATER COMM

If well telescopes please sketch and show depths.

GROUND LEVEL

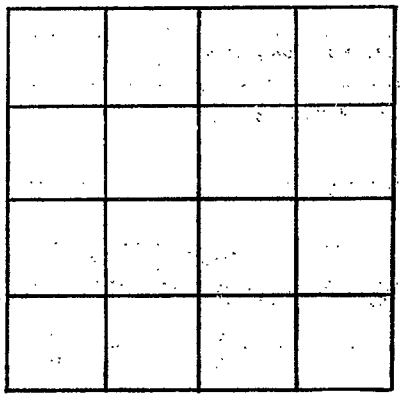

SECTION _____

Please indicate well location X.

ADDITIONAL INFORMATION

If more than one screen, show locations of each on sketch.