Newton
C 21
11-29-69

CODED

CODED

MISSISSIPPI
BOARD OF WATER COMMISSIONERS
416 North State Street
Jackson, Mississippi 39201

WATER WELL DRILLERS LOG

11-29 1969 RB Nicholson Newton
date well completed — firm name — county well located

LANDOWNER: J C Henry
Union
Miss.
(mailing address)

WELL LOCATION:
sec. 22 T 8 N/S R 12 E/W
4 (distance) miles S (direction) of Union (nearest town)

WELL PURPOSE: home
(home, irrigation, municipal, industrial)

WELL COMPLETION DATA:

(1) diameter (inches) 4 1/4"
(2) total depth (feet) 168
(3) static water level (feet) 119 below/above top of ground.
(4) casing Galv P (material), 163 (depth),
2" (size) if telescope see back.
(5) screen 5 (length), 168 (depth to top)
1 1/4 (size), Steel (material)
(6) pump 1 (HP) 8 (yield gpm)
Elect. (type power)
(7) electric log _____ (yes or no)
_____ (organization running log)
(8) how well bottom plugged _____

DRILLERS REMARKS: _____

description of formations encountered	from	to
Clay & Chalk	0	30
Mix Sand & dirt	30	50
Shell & Rock	50	140
~~140 142~~		
Sand mix dirt	140	150
water Sand	150	168

JAN 21 1970
MISS. BD. OF WATER COMM.

If well telescopes please sketch and show depths.

GROUND LEVEL

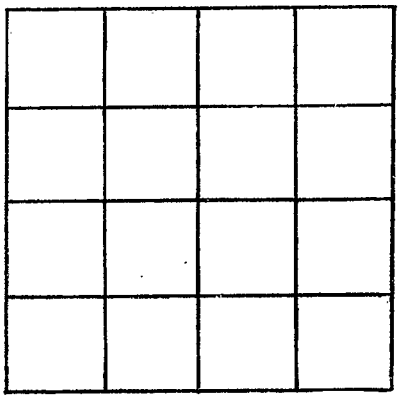

SECTION 22

Please indicate well location X.

ADDITIONAL INFORMATION

If more than one screen, show locations of each on sketch.