


D-18 ~~Ins info to locate~~ ?

WATER WELL DRILLERS LOG

5-13-61

Date: 5/13, 1961, Driller: Hester Ogletree ^{Mounton} County Washoba _(Name)

	Description & Color of Materials Sand, Clay, Red Clay, Shell, etc.	Thick- ness Feet	Depth Feet
(1) Owner of Land: <u>Will Mc Mahan</u> (Name) <u>Rt. 5 Union, Miss.</u> (Address)	<u>12 ft. g clay</u>		
(2) Location: <u>1/4, 1/4, Sec. 22 T8 R13</u> <u>9 miles Southeast of Union</u> (distance) (direction) (Nearest Town)	<u>132 ft. blue dirt</u> <u>some shell rock</u>		
(3) Topography: <u>Hilly</u> (Hilly) (Flat) (Level)	<u>30 ft. water sand</u>		
(4) Purpose of Well: <u>Home use</u> (Domestic Irrigation Municipal, Industrial, Other)			
Information upon completion of well:			
(1) Diameter <u>4 1/2</u> inches.			
(2) Total Depth <u>194</u> feet.			
(3) Water Level <u>110</u> feet below top of ground.			
(4) Cased to <u>147</u> , Size <u>2 in</u>			
(5) Screen: Size _____, Length _____			
(6) Were any formations sealed against pollution? _____ yes, _____ no.			
If YES depth of formation _____			
Why _____			
Drillers Remarks: _____			

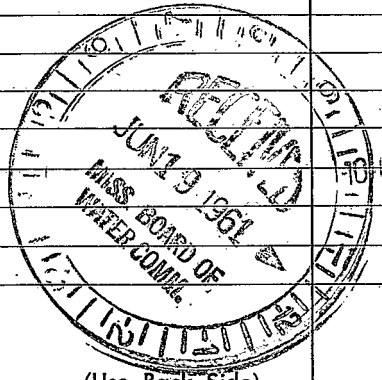

(Use Back Side)

Well No.


