

NEWTON  
E5

E

WATER WELL DRILLERS LOG

Newton  
Scott

6-30-62

FOREST DRILLING SERVICE

Date: 6/30, 1962

Driller: 231 Highway 35 North

County: Scott

FOREST, MISSISSIPPI

(1) Owner of Land: Dalton Gibson  
(Name)  
Conehatta, Miss.  
(Address)

(2) Location: 1/4, 1/4, Sec. 5 T 7<sup>N</sup> R 10<sup>E</sup>  
2 1/2 miles (distance) of Conehatta (Nearest Town)

(3) Topography:  (Hilly)  (Flat)  (Level)

(4) Purpose of Well: Chicken house  
(Domestic Irrigation, Municipal, Industrial, Other)

Description & Color of Materials Sand, Clay, Red Clay, Shell, etc.	Thick-ness Feet	Depth Feet
Clay + Red sand	0	20
Rock + sth. clay	12	32
Hard clay	20	52
Clay + Rock	10	62
Clay + sth. rock	30	92
Shell + sth. rock	10	102
fine sand	50	162
Clay	10	172
Clay + sth. fine sand	30	202
Clay	30	232
Clay + sth. sand	10	242
fine sand + sth. clay	30	272
Red sand	13	285

Information upon completion of well:

(1) Diameter 2" inches.

(2) Total Depth 285 feet.

(3) Water Level 111 feet below top of ground.

(4) Cased to 272, Size 2"


(5) Screen: Size 2", Length 12 ft

(6) Were any formations sealed against pollution?  
no

If YES depth of formation \_\_\_\_\_

Why \_\_\_\_\_

Drillers Remarks: \_\_\_\_\_

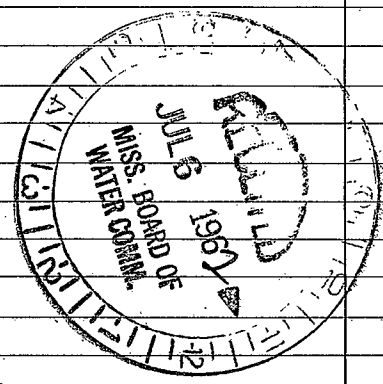

3

(Use Back Side)

Well No.







