Newton
E 2000
2-11-76

137

MISSISSIPPI
BOARD OF WATER COMMISSIONERS
416 North State Street
Jackson, Mississippi 39201

WATER WELL DRILLERS LOG

2-11-76 19 McDonald + Hill NEWTON
date well completed — firm name — county well located

LANDOWNER: ALLEN PERRY
RT 1 DECATUR
(mailing address)

WELL LOCATION:
sec. 12 T 7 (N) (S) R 10 (E) (W)
5 miles WEST of DECATUR
(distance) (direction) (nearest town)

WELL PURPOSE: HOME
(home, irrigation, municipal, industrial)

WELL COMPLETION DATA:
(1) diameter (inches) 4"
(2) total depth (feet) 280'
(3) static water level (feet) 95' below above top of ground.
(4) casing PVC (material), 180' (depth),
4" (size) if telescope see back.
(5) screen _____ (length), _____ (depth to top)
_____ (size), _____ (material)
(6) pump 1½ sub (HP) 10 (yield gpm)
E (type power)
(7) electric log _____ (yes or no)
_____ (organization running log)
(8) how well bottom plugged OPEN

DRILLERS REMARKS:

description of formations encountered	from	to
Clay	0	16
Sand	16	135
Soft Sandy	135	160
Shale	160	205
Rock & Shale	205	220
Sand	220	240
Sandy	240	280

RECEIVED
FEB 17 1976
MISS. BD. OF WATER COMM

If well telescopes please sketch and show depths.

GROUND LEVEL

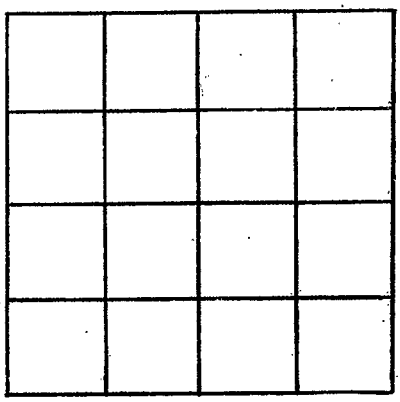

SECTION _____

Please indicate well location X.

ADDITIONAL INFORMATION

If more than one screen, show locations of each on sketch.