NEWTON

J 2014

9-1-78

MISSISSIPPI
BOARD OF WATER COMMISSIONERS
416 North State Street
Jackson, Mississippi 39201

WATER WELL DRILLERS LOG

9-1-78 19 McDonald & Hall Newton
date well completed — firm name — county well located

LANDOWNER: Mickey Parker
Rt #7 Lawrence
(mailing address)

WELL LOCATION:
sec 24 T 6 N/S R 10 E/W
2 (distance) miles N (direction) of Lawrence (nearest town)

WELL PURPOSE: None
(home, irrigation, municipal, industrial)

WELL COMPLETION DATA:
(1) diameter (inches) 4"
(2) total depth (feet) 520'
(3) static water level (feet) 125' below/above top of ground.
(4) casing PVC (material), 460' (depth), 4" (size) if telescope see back.
(5) screen — (length), — (depth to top)
— (size), — (material)
(6) pump 1½ (HP) 20 GPM (yield gpm)
E (type power)
(7) electric log — (yes or no)
(organization running log)
(8) how well bottom plugged open

DRILLERS REMARKS:

description of formations encountered	from	to
clay & sand	0	15
sand	15	95
shale	95	130
sandy shale	130	200
sand & shale	200	250
sand	250	350
sandy shale	350	430
shale	430	470
rock & shale	470	495
green sand	495	520

RECEIVED
SEP 11 1978
MISS. BD. OF WATER COMM.

If well telescopes please sketch and show depths.

GROUND LEVEL

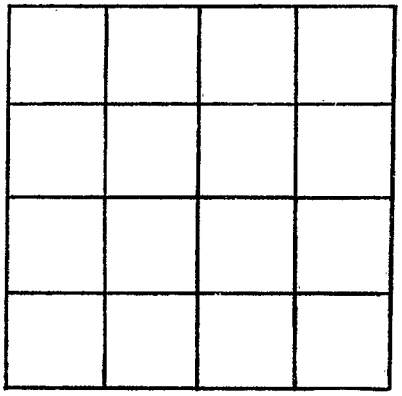

SECTION _____

Please indicate well location X.

ADDITIONAL INFORMATION

If more than one screen, show locations of each on sketch.