

K 20
5-3-63

WATER WELL DRILLERS LOG

Date 5-3, 1963, Driller: J. L. Spald County Newton
(Name)

(1) Owner of Land: M & T Farm
(Name)
Newton Miss
(Address)

(2) Location: W 1/4, NW 1/4, Sec 15 T20R11E
3 miles N, of Newton
(distance) (direction) (Nearest Town)

(3) Topography: (Hilly) (Flat) (Level)

(4) Purpose of Well: Domestic
(Domestic Irrigation
Municipal, Industrial, Other)

Description & Color of Materials Sand, Clay, Red Clay, Shell, etc.	Thick- ness Feet	Depth Feet
<u>S clay</u>	<u>22</u>	<u>0-22</u>
<u>Shell</u>	<u>22</u>	<u>22-44</u>
<u>Blue</u>	<u>93</u>	<u>44-137</u>
<u>Gray</u>	<u>32</u>	<u>137-169</u>
<u>Sand</u>	<u>51</u>	<u>169-220</u>


Information upon completion of well:

- (1) Diameter 2 inches.
- (2) Total Depth 210 feet.
- (3) Water Level 60 feet below top of ground.
- (4) Cased to 210, Size 2"
- (5) Screen: Size 10ft length 10'
- (6) Were any formations sealed against pollution?
_____ yes, no.

If YES depth of formation _____

Why _____

Drillers Remarks: _____

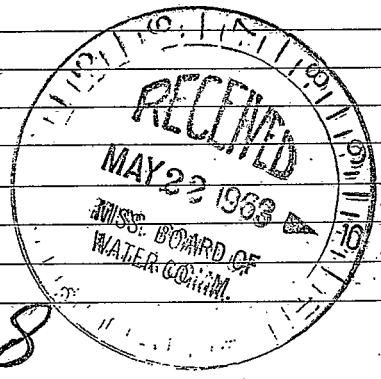

8

63

Well No.

(Use Back Side)





