

3 K37

7-9-62

WATER WELL DRILLERS LOG

Date: 7-9, 1962, Driller: U. L. Melch County Newton
 (Name)

(1) Owner of Land: J. P. Humphreys
 (Name)
Lawrence Moss
 (Address)

(2) Location: NE 1/4, SE 1/4, Sec. 30 T. 6 R. 11
3 miles N. West, of Newton
 (distance) (direction) (Nearest Town)

(3) Topography: (Hilly) (Flat) (Level)

(4) Purpose of Well: Domestic
 (Domestic Irrigation
 Municipal, Industrial, Other)

Description & Color of Materials Sand, Clay, Red Clay, Shell, etc.	Thick- ness Feet	Depth Feet
<u>R. clay</u>	<u>12</u>	<u>0-12</u>
<u>blue</u>	<u>20</u>	<u>12-32</u>
<u>Brown</u>	<u>11</u>	<u>32-43</u>
<u>Brown & sandy</u>	<u>21</u>	<u>43-64</u>
<u>Sand</u>	<u>47</u>	<u>64-111</u>

Information upon completion of well:

(1) Diameter 2 inches.

(2) Total Depth 111 feet.

(3) Water Level 38 feet below top of ground.


(4) Cased to 111, Size 2"

(5) Screen: Size 2" 8 slot, Length 6'

(6) Were any formations sealed against pollution?
 _____ yes, no.

If YES depth of formation _____
 Why _____

Drillers Remarks: _____

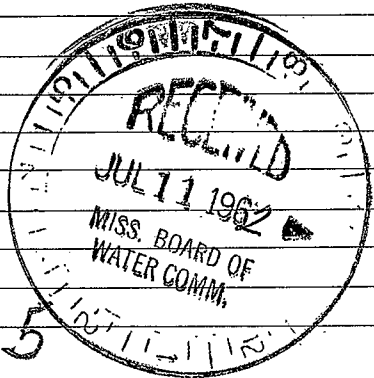

5

47

(Use Back Side)

Well No.















