Newton
K 2022
6-11-80

MISSISSIPPI
BOARD OF WATER COMMISSIONERS
416 North State Street
Jackson, Mississippi 39201

WATER WELL DRILLERS LOG

6-11-80 19 McDonald Well Newton
date well completed — firm name — county well located

LANDOWNER: Sara Greenwood
Newton
(mailing address)

WELL LOCATION:
sec. 14 T 6 N/S R 11 E/W
1 (distance) miles N (direction) of Newton (nearest town)

WELL PURPOSE: Home
(home, irrigation, municipal, industrial)

WELL COMPLETION DATA:

(1) diameter (inches) 4"
(2) total depth (feet) 330'
(3) static water level (feet) 85' below above top of ground.
(4) casing PVC (material), 265' (depth), 4" (size) If telescope see back.
(5) screen — (length), — (depth to top)
— (size), — (material)
(6) pump ½ (HP) 10 gpm (yield/gpm)
F (type power)
(7) electric log — (yes or no)
(organization running log)
(8) how well bottom plugged Open

DRILLERS REMARKS:

description of formations encountered	from	to
Clay & sand	0	22
Shale	22	40
Sand & shale	40	60
Sand & clay & lignite	60	210
Sandy shale	210	250
Shale	250	285
Rock & shells	285	312
Green sand & sandy shale	312	330

DEPT. OF NATURAL RESOURCES
BUREAU OF LAND & WATER RESOURCES
JUN 18 1980
RECEIVED

If well telescopes please sketch and show depths.

GROUND LEVEL

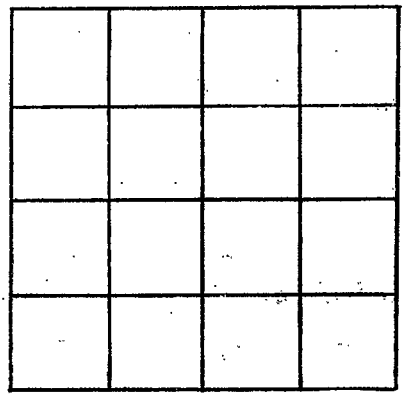

SECTION _____

Please indicate well location X.

ADDITIONAL INFORMATION

If more than one screen, show locations of each on sketch.