

L19
6-17-63

WATER WELL DRILLERS LOG

P

Date: 6-17, 1963 Driller: J. L. Walden County Newton
(Name)

(1) Owner of Land: J. L. Walden
(Name)
Hickory Miss.
(Address)

(2) Location: NW 1/4, SW 1/4, Sec 26 T6 R14 W J2
1 miles NW, of Hickory
(distance) (direction) (Nearest Town)

(3) Topography: (Hilly) (Flat) (Level)

(4) Purpose of Well: Domestic
(Domestic Irrigation
Municipal, Industrial, Other)

Description & Color of Materials Sand, Clay, Red Clay, Shell, etc.	Thick- ness Feet	Depth Feet
<u>Clay</u>	<u>71</u>	<u>0-11</u>
<u>Blue</u>	<u>42</u>	<u>11-53</u>
<u>W J2</u>	<u>57</u>	<u>53-110</u>

Information upon completion of well:

(1) Diameter 2" inches.

(2) Total Depth 110 feet.

(3) Water Level 30 feet below top of ground.

(4) Cased to 110, Size 2"


(5) Screen: Size 2", Length 6'

(6) Were any formations sealed against pollution?
_____ yes, no.

If YES depth of formation _____

Why _____

Drillers Remarks: _____

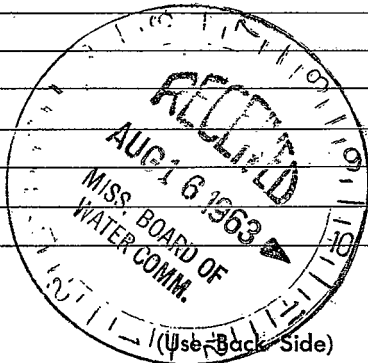

-67 Well No.






