

L 29

7-15-64

WATER WELL DRILLERS LOG

Date: 7-15, 1964, Driller: W. L. Shell county Newton

(Name)

(1) Owner of Land: W.B. Kendrick

(Name)

Hickory

(Address)

(2) Location: 1/4, 1/4, Sec. 35 T.6 R.12

Corner of Hickory

miles

of

(distance)

(direction)

(Nearest Town)

(3) Topography:

(Hilly)

(Flat)

(Level)

(4) Purpose of Well: Domestic

(Domestic Irrigation)

(Municipal, Industrial, Other)

Information upon completion of well:

(1) Diameter: 2 inches.

(2) Total Depth: 85 feet.

(3) Water Level: 18 feet below top of ground.

(4) Cased to: 85, Size: 2

(5) Screen: Size # 85 Length 5'

(6) Were any formations sealed against pollution?

yes, no.

If YES depth of formation

Why

Drillers Remarks:


Description & Color of Materials Sand, Clay, Red Clay, Shell, etc.

Thickness Feet

Depth Feet

Clay
Blue
Sand

110-11
52 11-63
22 23-85

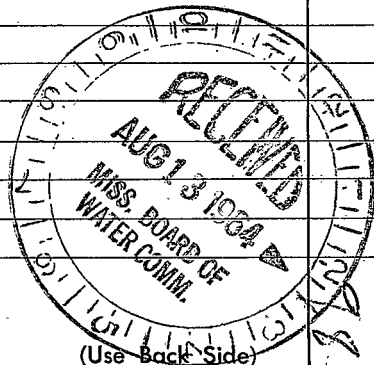

(Use Back Side)

Well No.






