MISSISSIPPI DEPARTMENT OF NATURAL RESOURCES

Bureau of Land and Water Resources

P.O. Box 10631
Jackson, Mississippi 39209
WATER WELL DRILLERS LOG

COUNTY WELL LOCATED	NEWTON
WELL NUMBER	L-91
CODED	CODED
DATE WELL COMPLETED	1-26-87
PERMIT NUMBER	McDONALD + HILL INC
NAME OF DRILLING FIRM	MERIDIAN MS

NAME & MAILING ADDRESS OF LANDOWNER: LITTLE ROCK BAPTIST CHURCH HICKORY MS

WELL LOCATION:	SEC	TOWNSHIP	RANGE
SW¼	10	6 (N) S	12 (E) W

DISTANCE	DIRECTION	NEAREST TOWN
3 Miles	NORTH	of Hickory

OTHER LANDMARK: ON Hwy 503

WELL PURPOSE: Home, Irrigation, Municipal, Industrial, Fish Pond, etc. Church

PUMP DATA

PUMP TYPE (Circle One): Submersible, Turbine, (Jet) Flowing Well, Other (Describe) _____

POWER TYPE (Circle One): Electric, Tractor, Diesel, Gasoline, Butane, Other (Describe) _____

Pump Capacity (GPM)	No. of Stages	Setting Depth
5	2	FT.

PUMP TEST

Well yielded _____ GPM with a drawdown of _____ ft. after _____ hours of pumping

WELL DATA

Well Depth	Casing Diameter (In.)	Casing Length (Ft.)
125'	2"	115

Type of Casing	Hole Depth	Depth to Static Water Level
PVC	125	92'

TYPE OF COMPLETION: (Circle One or More): Gravel Packed, Underreamed, Telescoped, Natural Development, Open Hole, Other (Describe) SAND PACKED

Top of Lap Pipe or Reduction in Casing FEET

IF TELESCOPED OR MORE THAN ONE SCREEN: USE BACK PAGE

LOG DATA

TYPE OF LOG RUN (Circle One): No Log Run, Electric, Gamma Ray, Density, Sonic, Neutron, Other (Describe) _____

Name of Organization Running Log

GEOLOGIC DATA (Office Use Only)

Surface Elev.	Geologic Unit	Unit Thickness	Depth to Top
Subs. SWL	Date	Analysis	Aquifer Test

Driller's Remarks

RECEIVED
FEB 11 1987
Department of Natural Resources
Bureau of Land & Water Resources

SCREEN DATA

Diameter - Inches	Length - Feet	Slot Size - Inches
2"	10'	18'

Screen Type	Depth to Bottom - Feet
PVC	120'

DESCRIPTION OF FORMATIONS ENCOUNTERED	FROM	TO
CLAY	0	20
SHALE	20	55
SAND	55	125

FORMATIONS (Continued)	FROM	TO

IF MORE SPACE IS NEEDED, USE BACK

If well telescopes please
sketch and show depths.

GROUND LEVEL

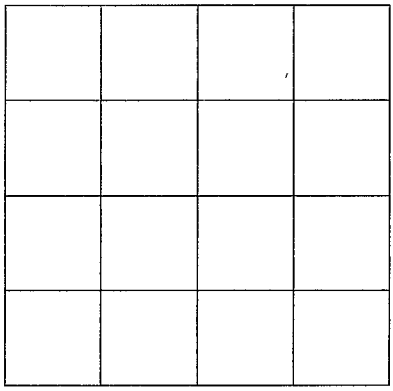

SECTION _____

Please indicate well location X.

ADDITIONAL INFORMATION

If more than one screen,
show location of each on sketch.