NEWTON
L 2045
9-22-80

MISSISSIPPI DEPARTMENT OF NATURAL RESOURCES

Bureau of Land and Water Resources
Southport Mall
P.O. Box 10631
Jackson, Mississippi 39209

WATER WELL DRILLERS LOG

4

9-22-80 19 — McDonald & Hill — Newton
date well completed — firm name — county well located

LANDOWNER: Jimmy Crawford
Rt 1 Decatur
(mailing address)

WELL LOCATION:
sec. 3 T 6 (N/S) R 12 (E/W)
5 miles 5 of Decatur
(distance) (direction) (nearest town)

WELL PURPOSE: home
(home, irrigation, municipal, industrial)

WELL COMPLETION DATA:
(1) diameter (inches) 4"
(2) total depth (feet) 220'
(3) static water level (feet) 85' below above top of ground.
(4) casing PVC (material), 150' (depth),
4" (size) If telescope see back.
(5) screen — (length), — (depth to top)
— (size), — (material)
(6) pump 1/2 (HP) 8 GPM (yield gpm)
E (type power)
(7) electric log — (yes or no)
— (organization running log)
(8) how well bottom plugged Open

DRILLERS REMARKS:

description of formations encountered	from	to
Clay & sand	0	25
shale & sand & clay	25	50
sand	50	130
sandy shale	130	145
shale	145	179
rock & shells	179	205
green sand & sandy shale	205	220

DEPT. OF NATURAL RESOURCES
BUREAU OF LAND & WATER RESOURCES
SEP 29 1980
RECEIVED

If well telescopes please sketch and show depths.

GROUND LEVEL

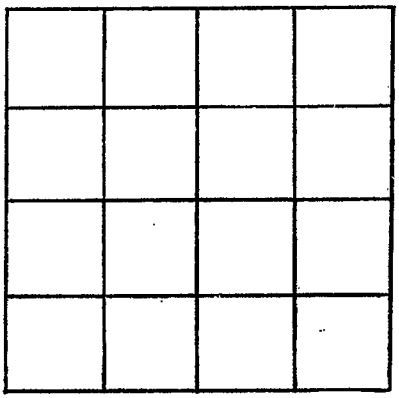

SECTION _____

Please indicate well location X.

ADDITIONAL INFORMATION

If more than one screen, show locations of each on sketch.