

MISSISSIPPI DEPARTMENT OF NATURAL RESOURCES

Bureau of Land and Water Resources

Southport Mall

P.O. Box 10631

Jackson, Mississippi 39209

WATER WELL DRILLERS LOG

Newton
L
2074

1-21-1986 McDonald + Hite Newton
date well completed firm name county well located

LANDOWNER: Ernest Ledlow
Box 247
Newton, MS
(mailing address)


WELL LOCATION:
sec. 8 T. 6 N. R. 12 E
5 NW W
miles of
(distance) (direction) (nearest town)

WELL PURPOSE: Home
(home, irrigation, municipal, industrial)

- WELL COMPLETION DATA:
- (1) diameter (inches) 4
 - (2) total depth (feet) 260
 - (3) static water level (feet) 130 below top of ground.
 - (4) casing PVC 202
(material) (depth)
(size) if telescope see back.
 - (5) screen none
(length) (depth to top)
(size) (material)
 - (6) pump (HP) (yield gpm)
(type power)
 - (7) electric log (yes or no)
(organization running log)
 - (8) how well bottom plugged

Description of formations encountered	from	to
clay	0	20
shale	20	35
sand	35	165
soft shale	165	185
red shale	185	218
rock, shells	218	240
green sand	240	260

ERNEST LEDLOW

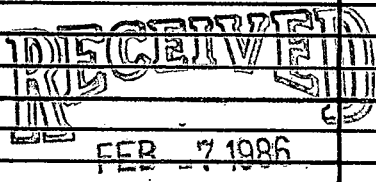


Department of Natural Resources
Bureau of Land & Water Resources

DRILLERS REMARKS:
Set pump 180 ft.

If well telescopes please
sketch and show depths.

GROUND LEVEL

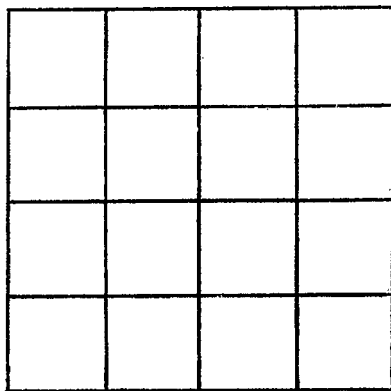

SECTION _____

Please indicate well location X.

ADDITIONAL INFORMATION

If more than one screen,
show locations of each on sketch.