

6 NEWTON

P1

WATER WELL DRILLERS LOG

M17

Date: 2-13-64, 1964, Driller: Mc Donald & Hill Inc


(Name)

(1) Owner of Land: JAMES CRAPT
(Name)
CHUCKY MISS
(Address)

(2) Location: 1/4, 1/4, Sec. 25 6N 13E
_____ miles _____ of _____
(distance) (direction) (Nearest Town)

(3) Topography: (Hilly) _____ (Flat) _____ (Level)

(4) Purpose of Well:
(Domestic Irrigation
Municipal, Industrial, Other)


Description & Color of Materials
Sand, Clay, Red Clay, Shell, etc.

Thick-
ness
Feet

Depth
Feet

SHALE ST SHALE
SAND

0 118
118 110

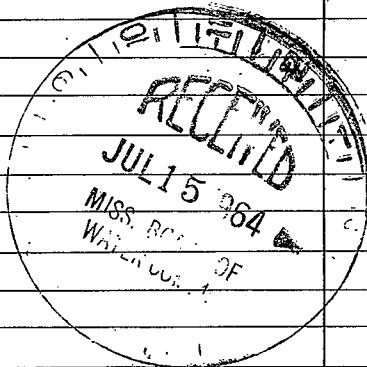

Information upon completion of well:

(1) Diameter: 3 1/4 inches.

(2) Total Depth: 140 feet.

(3) Water Level: 170' feet below top of ground.

(4) Cased to: 134', Size: 2"

(5) Screen: Size: 2", Length: 5'

(6) Were any formations sealed against pollution?

_____ yes, _____ no.

If YES depth of formation _____

Why _____

Drillers Remarks: _____

Well No.

(Use Back Side)









