Newton
M 2000
10-9-75

MISSISSIPPI
BOARD OF WATER COMMISSIONERS
416 North State Street
Jackson, Mississippi 39201

WATER WELL DRILLERS LOG

10-9 1975 H. L. Helek Newton
date well completed — firm name — county well located

LANDOWNER: James Holt
Hickory
Miss
(mailing address)

WELL LOCATION:
sec. 1 T 6 (N/S) R 13 (E/W) 13P
6 miles NE of Hickory
(distance) (direction) (nearest town)

WELL PURPOSE: Home
(home, irrigation, municipal, industrial)

WELL COMPLETION DATA:

(1) diameter (inches) 3"
(2) total depth (feet) 260
(3) static water level (feet) 41 below above top of ground.
(4) casing PVC (material), (depth), (size) if telescope see back.
(5) screen None (length) (depth to top)
Open Hole (size) (material)
(6) pump 1 (HP) 200 (yield gpm)
elec (type power)
(7) electric log (yes or no)
(organization running log)
(8) how well bottom plugged

DRILLERS REMARKS:

description of formations encountered	from	to
Clay	0	16
Rocky + Blue	16	160
Blue	160	200
Sand	200	260

RECEIVED NOV 6 1975 MISS. BD. OF WATER COMM.

If well telescopes please sketch and show depths.

GROUND LEVEL

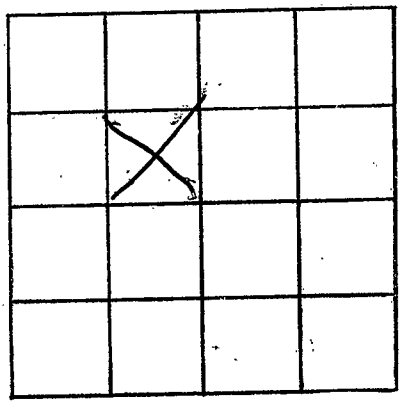

SECTION _____

Please indicate well location X.

ADDITIONAL INFORMATION

If more than one screen, show locations of each on sketch.