NEWTON
M 234
4-22-81

MISSISSIPPI DEPARTMENT OF NATURAL RESOURCES

Bureau of Land and Water Resources
Southport Mall
P.O. Box 10631
Jackson, Mississippi 39209

WATER WELL DRILLERS LOG

4-22-81 19 McDonald & Hill Newton
date well completed — firm name — county well located

LANDOWNER: Phillip Harris
Hickory
(mailing address)

WELL LOCATION:
sec. 13 T 6 (N) R 13 E
S W
4 miles NE of Hickory
(distance) (direction) (nearest town)

WELL PURPOSE: home
(home, irrigation, municipal, industrial)

WELL COMPLETION DATA:

(1) diameter (inches) 4"
(2) total depth (feet) 300'
(3) static water level (feet) 105' below above top of ground.
(4) casing PVC (material), 107' (depth),
4" (size) if telescope see back.
(5) screen — (length), — (depth to top)
— (size), — (material)
(6) pump 1/2 (HP) 8 GPM (yield gpm)
E (type power)
(7) electric log — (yes or no)
(organization running log)
(8) how well bottom plugged open

DRILLERS REMARKS:

description of formations encountered	from	to
clay	0	10
sand	10	60
sandy shale	60	90
shale	90	112
rock & shells	112	145
green sand & sandy shale	145	160
shale & rock	160	270
sand	270	300

DEPT. OF NATURAL RESOURCES
BUREAU OF LAND & WATER RESOURCES
APR 28 1981
RECEIVED

If well telescopes please sketch and show depths.

GROUND LEVEL

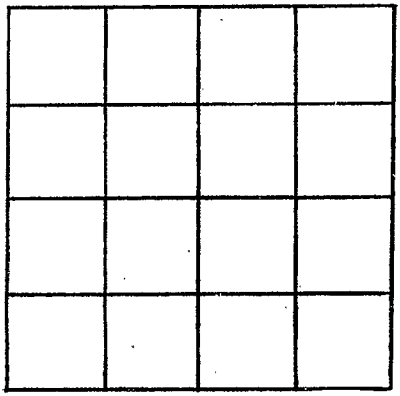

SECTION _____

Please indicate well location X.

ADDITIONAL INFORMATION

If more than one screen, show locations of each on sketch.