MISSISSIPPI DEPARTMENT OF ENVIRONMENTAL QUALITY
Office of Land and Water Resources

P. O. Box 10631
Jackson, MS 39289-0631

WATER WELL DRILLERS LOG

COUNTY WELL LOCATED: Newton	
WELL NUMBER: N 2091	CODED:
DATE WELL COMPLETED: 8/1/94	
PERMIT NUMBER:	
NAME OF DRILLING FIRM: McDonald + Hall Meridian, Miss.	

NAME & MAILING ADDRESS OF LANDOWNER
Grady Johnson
P.O. Box 12
Chunky, Miss.

WELL LOCATION: SEC	TOWNSHIP	RANGE
2	6 (N) S	13 (E) W

DISTANCE	DIRECTION	NEAREST TOWN
3 Miles	N of	Chunky

OTHER LANDMARK

WELL PURPOSE: (Home) Irrigation, Municipal, Industrial, Fish Pond, etc.

PUMP DATA

PUMP TYPE (Circle One): (Submersible,) Turbine, Jet, Flowing Well, Other (Describe)

POWER TYPE (Circle One): (Electric,) Tractor, Diesel, Gasoline, Butane, Other (Describe) H/P

Pump Capacity (GPM)	No. of Stages	Setting Depth
8	10	160 FT.

PUMP TEST

Well yielded 15 GPM with a drawdown of 15 ft. after 4 hours of pumping

WELL DATA

Well Depth	Casing Diameter (In.)	Casing Length (Ft.)
192	4	182

Type of Casing	Hole Depth	Depth to Static Water Level
PVC	192	135

TYPE OF COMPLETION: (Circle One or More): (Gravel Packed) Underreamed, Telescoped, Natural Development, Open Hole, Other (Describe)

WELL GROUTED TO A DEPTH OF _____ FEET
Type Grout (circle one): Cement, Bentonite, or Mix

LOG DATA

TYPE OF LOG RUN (Circle One): No Log Run, Electric, Gamma Ray, Density, Sonic, Neutron, Other (Describe)

Name of Organization Running Log

GEOLOGIC DATA (Office Use Only)

Surface Elev.	Geologic Unit	Unit Thickness	Depth to Top
Subs. SWL	Date	Analysis	Aquifer Test

Driller's Remarks

Top of Lap Pipe or Reduction in Casing
FEET
IF TELESCOPED OR MORE THAN ONE SCREEN: USE BACK PAGE

SCREEN DATA

Diameter - Inches	Length - Feet	Slot Size - Inches
4	10	.012

Screen Type	Depth to Bottom - Feet
PVC	192

DESCRIPTION OF FORMATIONS ENCOUNTERED	FROM	TO
Clay + Sand	0	38
Shale + Sst Rock	38	155
Sand	155	192

FORMATIONS CONTINUED	FROM	TO

IF MORE SPACE IS NEEDED, USE BACK

RECEIVED
AUG 09 1994
Dept. of Environmental Quality
Office of Land & Water Resources

If well telescopes please sketch and show depths.

GROUND LEVEL

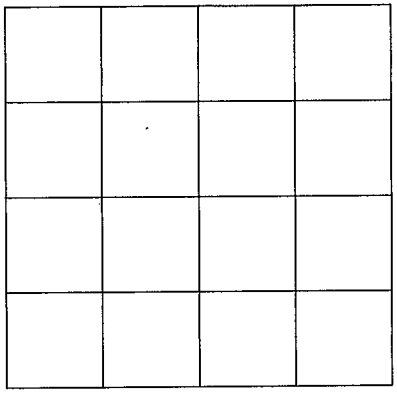

SECTION _____

Please indicate well location X.

ADDITIONAL INFORMATION

If more than one screen, show location of each on sketch.