

3
NEWTON

N3

WATER WELL DRILLERS LOG

P

Date: 6-27-66, 1966 Driller: W. L. Sheld County Newton
(Name)

| (1) Owner of Land: <u>M. Nicholson</u> (Name) | Description & Color of Materials Sand, Clay, Red Clay, Shell, etc. | Thick- ness Feet | Depth Feet |
|---|---|------------------------|--------------------------------------|
| <u>Lawrence Weiss</u> (Address) | <u>Clay</u> | <u>22</u> | <u>0-22</u> |
| (2) Location: <u>SE 1/4, SE 1/4, Sec. 13 T5R10E</u> | <u>Blue</u> | <u>42</u> | <u>22-64</u> |
| <u>1/4</u> miles <u>South</u> of <u>Lawrence</u> (distance) (direction) (Nearest Town) | <u>Blue + Shell</u> | <u>17</u> | <u>64-81</u> |
| (3) Topography: <input checked="" type="checkbox"/> (Hilly) <input checked="" type="checkbox"/> (Flat) <input type="checkbox"/> (Level) | <u>Sandy + Blue</u> | <u>95</u> | <u>106-201</u> |
| (4) Purpose of Well: <u>Domestic</u> (Domestic Irrigation Municipal, Industrial, Other) | <u>Sand</u> | <u>51</u> | <u>201</u> <u>↓</u> <u>252</u> |


Information upon completion of well:

- (1) Diameter 2 inches.
- (2) Total Depth 252 feet.
- (3) Water Level 35 feet below top of ground.
- (4) Cased to 252, Size 2"
- (5) Screen: Size 80/100 Length 12'
- (6) Were any formations sealed against pollution?
_____ yes, no.

If YES depth of formation _____

Why _____

Drillers Remarks: _____

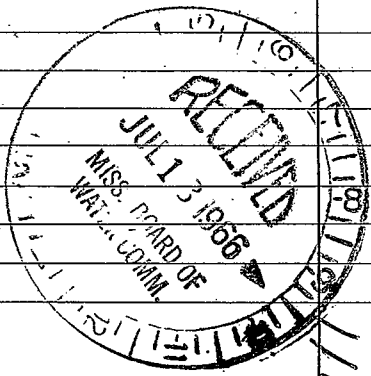

3

(Use Back Side)

Well No. 116




