Newton
024
10-10-68

MISSISSIPPI
BOARD OF WATER COMMISSIONERS
416 North State Street
Jackson, Mississippi 39201

CODED

WATER WELL DRILLERS LOG

10/10 1968 Conover Drilling Service Newton
date well completed — firm name — county well located

LANDOWNER: E.C Russell
Newton Miss Box 184-A
(mailing address)

WELL LOCATION:
sec. 14 T 5 N/S R 11 E/W
2 (distance) miles 5 (direction) of Newton (nearest town)

WELL PURPOSE: Home
(home, irrigation, municipal, industrial)

WELL COMPLETION DATA:

(1) diameter (inches) 2"
(2) total depth (feet) 280
(3) static water level (feet) 52 below/above top of ground.
(4) casing Steel (material), 295 (depth),
_____ (size) if telescope see back.
(5) screen 5 (length), 245 (depth to top)
2" (size), 5 (material)
(6) pump 1" (HP) 350 GPM (yield gpm)
_____ (type power)
(7) electric log X (yes or no)
_____ (organization running log)
(8) how well bottom plugged _____

DRILLERS REMARKS: _____

description of formations encountered	from	to
Clay	0	18
Rock	18	19
Yellow Clay	19	28
Sand	28	33
Clay & Shell	33	115
Fine Sand &		
Clay	115	168
Clay &	168	245
Fine Sand	245	265
Coarse Sand	265	280

CODED

FEB 12 1969
MISS. BD. OF WATER COMM.

If well telescopes please sketch and show depths.

GROUND LEVEL

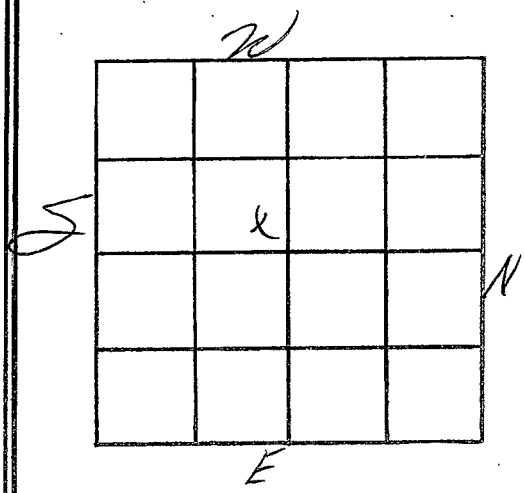

SECTION 14

Please indicate well location X.

ADDITIONAL INFORMATION

If more than one screen, show locations of each on sketch.