NEWTON
Q 2000
2-20-76

13P

MISSISSIPPI
BOARD OF WATER COMMISSIONERS
416 North State Street
Jackson, Mississippi 39201

WATER WELL DRILLERS LOG

2.20.76 19 McDonald + Hill NEWTON
date well completed firm name county well located

LANDOWNER: GEORGE RATLIFF
Rt #1, Chunky, Miss
(mailing address)

WELL LOCATION:
sec. 1 T 5 (N) S R 13 (E) W
3 miles SOUTH of CHUNKY
(distance) (direction) (nearest town)

WELL PURPOSE: HOME
(home, irrigation, municipal, industrial)

WELL COMPLETION DATA:
(1) diameter (inches) 4"
(2) total depth (feet) 300'
(3) static water level (feet) 108 below ~~above~~ top of ground.
(4) casing DVC (material), 90' (depth),
4" (size) if telescope see back.
(5) screen ——— (length), ——— (depth to top)
——— (size), ——— (material)
(6) pump ½ SUB (HP) 10 (yield gpm)
E (type power)
(7) electric log ——— (yes or no)
——— (organization running log)
(8) how well bottom plugged OPEN

DRILLERS REMARKS:

description of formations encountered	from	to
Sand	0	62
Soft Shale Sandy	62	80
Shale	80	98
Rock + Shale	98	120
Green Sand	120	138
Shale + Rock	138	240
Sand	240	300

RECEIVED
MAR 1 1976
BOARD OF WATER COMM.

If well telescopes please sketch and show depths.

GROUND LEVEL

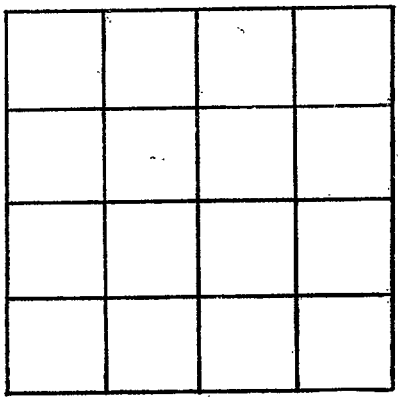

SECTION _____

Please indicate well location X.

ADDITIONAL INFORMATION

If more than one screen, show locations of each on sketch.