OKTIBBEHA
D46
Elog #57

CODED

MISSISSIPPI
BOARD OF WATER COMMISSIONERS
416 North State Street
Jackson, Mississippi 39201

WATER WELL DRILLERS LOG

_____ 19 Herndon Well & Supply Company Oktibbeha
date well completed — firm name — county well located

LANDOWNER: Mhoon Farm Water Association
Oktibbeha County, Miss.
(mailing address)

WELL LOCATION:
sec. 8 T 19 N R 15 E
5 miles E of Starkville
(distance) (direction) (nearest town)

WELL PURPOSE: Rural Water System
(home, irrigation, municipal, industrial)

WELL COMPLETION DATA:
(1) diameter (inches) 8 x 4
(2) total depth (feet) 1234
(3) static water level (feet) 126 below above top of ground.
(4) casing Steel (material), 502 (depth), 8 (size) if telescope see back.
(5) screen 50 (length), _____ (depth to top), 4 (size), Stainless St. (material)
(6) pump 15 (HP) 138 (yield gpm)
Electric (type power)
(7) electric log yes (yes or no)
U. S. Geological (organization running log)
(8) how well bottom plugged Backwash Valve

DRILLERS REMARKS:

description of formations encountered	from	to
Lime Rock	0	26
Blue Rock	26	330
Sandy Blue Rock	330	490
Shell Rock	490	495
Tight Sand	495	622
Gumbo (Streaks sand)	622	676
Tight sand	676	744
Gumbo	744	810
Tight asnd and gumbo	810	930
Sand (fine)	930	948
Gumbo	948	1009
Fine sand streaks gumbo	1009	1071
Gumbo	1071	1120
Sand	1120	1200
Pink Gumbo	1200	1235

CODED

1120 to 80

DEC 15 1972
MISS. BD. OF WATER COMM.

D

If well telescopes please sketch and show depths.

GROUND LEVEL

If more than one screen, show locations of each on sketch.

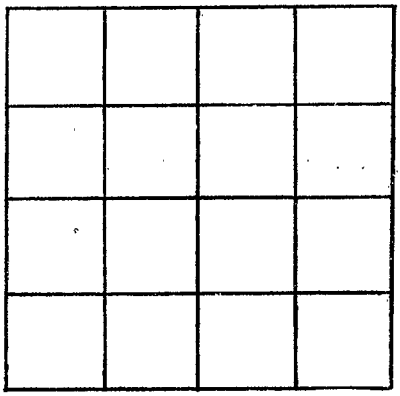

SECTION 8

Please indicate well location X.

ADDITIONAL INFORMATION