Oktibbeha
H 2004
6/01/77

13E

MISSISSIPPI
BOARD OF WATER COMMISSIONERS
416 North State Street
Jackson, Mississippi 39201

WATER WELL DRILLERS LOG

June 1977 HERMAN ECHOLS OKTIBBEHA
date well completed — firm name — county well located

LANDOWNER: Perry Rose
R7 D# 4
STARKVILLE MISS
(mailing address)

WELL LOCATION:
sec. 1 T 18 (N/S) R 15 (E/W)
5 (distance) miles NORTH (direction) of ARTESIA (nearest town)

WELL PURPOSE: HOME
(home, irrigation, municipal, industrial)

WELL COMPLETION DATA:

(1) diameter (inches)
(2) total depth (feet) 454
(3) static water level (feet) 100 below above top of ground.
(4) casing 20' 6" (material), Plastic (depth);
(size) if telescope see back.
(5) screen (length), (depth to top)
(size), (material)
(6) pump 1/2 (HP) 10 (yield gpm)
Elect. (type power)
(7) electric log (yes or no)
(organization running log)
(8) how well bottom plugged 0

DRILLERS REMARKS:

description of formations encountered	from	to
Sandy Clay	0	10
Chalk	10	340
Sand	340	454

RECEIVED
AUG - 1 1977
MISS. BD. OF WATER COMM.

If well telescopes please sketch and show depths.

GROUND LEVEL

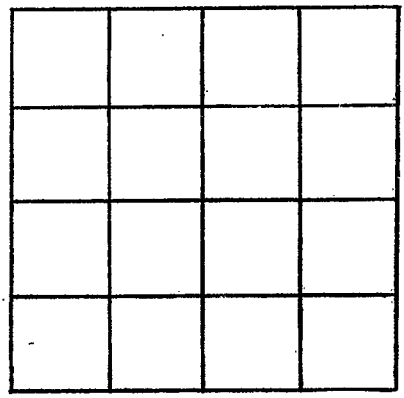

SECTION _____

Please indicate well location X.

ADDITIONAL INFORMATION

If more than one screen, show locations of each on sketch.