OKTibbeha
J9
8-64
U.S.G.S.

MISSISSIPPI
BOARD OF WATER COMMISSIONERS
416 North State Street
Jackson, Mississippi 39201

CODED

WATER WELL DRILLERS LOG

Aug 1964 19 T.M. Parks Drlg Co. Oktibbeha
date well completed — firm name — county well located

LANDOWNER: Morgan Chapel Water Assn. Inc.
Sturges, Miss.
(mailing address)

WELL LOCATION:
sec. 23 T 17N R 12 E
7 miles SE of Sturges
(distance) (direction) (nearest town)

WELL PURPOSE: Municipal
(home, irrigation, municipal, industrial)

WELL COMPLETION DATA:
(1) diameter (inches) 8
(2) total depth (feet) 2313
(3) static water level (feet) 168 below ~~above~~ top of ground.
(4) casing 8" (material), 550' (depth),
4 (size) if telescope see back.
(5) screen 80 (length), (depth to top)
4 (size), Stainless (material)
(6) pump 15 (HP) 100 (yield gpm)
3 Phase (type power)
(7) electric log yes (yes or no)
U.S. (organization running log)
(8) how well bottom plugged BPV.

DRILLERS REMARKS: Well was drilled deeper After 1st log. There was a 2nd log.

description of formations encountered	from	to
Not Available	0	1380
Sandy Shale	1380	1485
Hard Shale & Sand	1485	1555
Sand Fine	1555	1630
Hard Shale Gumbo + Sandy Rock	1630	1740
Sandy Rock w/gum	1740	1810
Shale w/ Major Rock	1810	2273
Sand & Shale	2273	2300
TD	2313	

CODED

APR 17 1969
MISS. BD. OF WATER COMM.

If well telescopes please sketch and show depts.

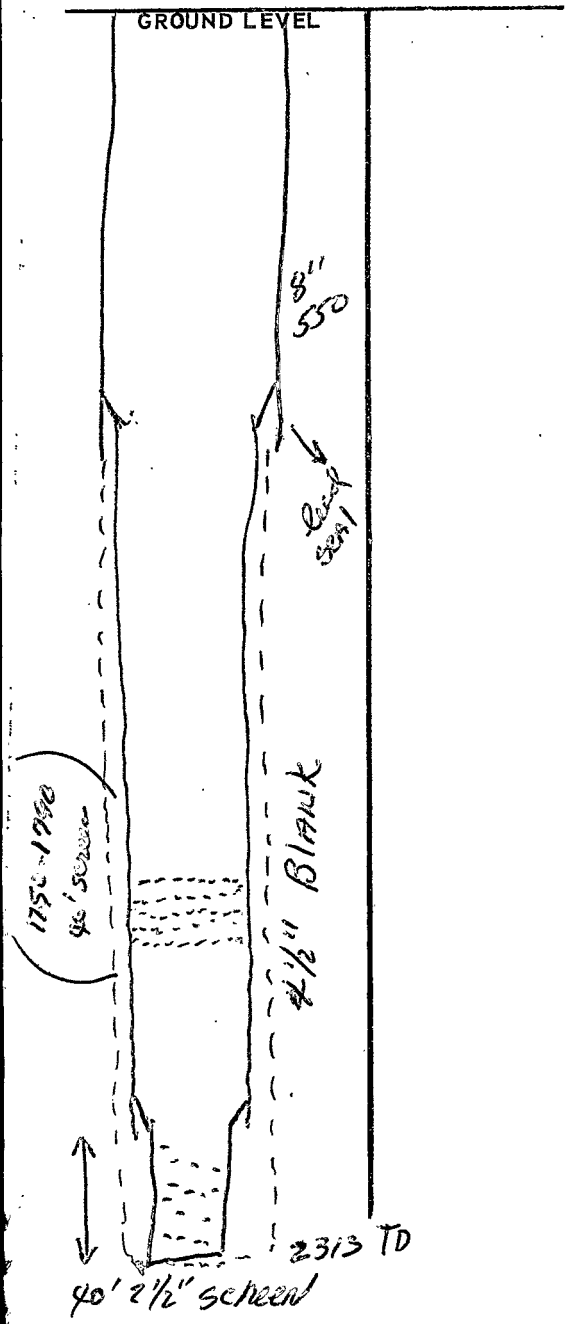

If more than one screen, show locations of each on sketch.

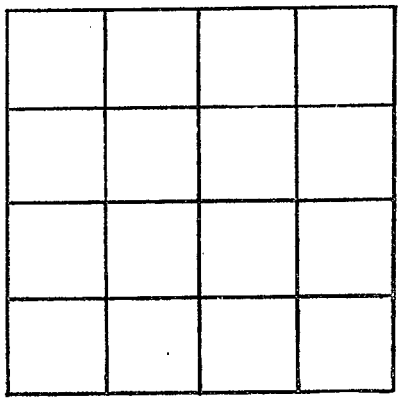

SECTION 23

Please indicate well location X.

ADDITIONAL INFORMATION