MISSISSIPPI DEPARTMENT OF NATURAL RESOURCES

Bureau of Land and Water Resources

P.O. Box 10631
Jackson, Mississippi 39209
WATER WELL DRILLERS LOG

COUNTY WELL LOCATED	PAN 012
WELL NUMBER	A 2023
CODED	
DATE WELL COMPLETED	11-21-89

PERMIT NUMBER: HICKS WELL CO.

NAME OF DRILLING FIRM: RT. 1 BOX 157 SENATOBIA, MS 38668

NAME & MAILING ADDRESS OF LANDOWNER: A.C. Gillis, Senatobia, MS 38668

WELL LOCATION: SEC 24 TOWNSHIP 6 (N/S) RANGE 9 (E/W)

DISTANCE 7 Miles DIRECTION West of NEAREST TOWN Como

OTHER LANDMARK:

WELL PURPOSE: Home, Irrigation, Municipal, Industrial, Fish Pond, etc.: Home

PUMP DATA

PUMP TYPE (Circle One): (Submersible) Turbine, Jet Flowing Well, Other (Describe) ____

POWER TYPE (Circle One): (Electric) Tractor, Diesel, Gasoline, Butane, Other (Describe) ____ H/P 3/4

Pump Capacity (GPM)	No. of Stages	Setting Depth
10	12	175 FT.

PUMP TEST

Well yielded 10 GPM with

a drawdown of — ft.

after — hours of pumping

WELL DATA

Well Depth	Casing Diameter (In.)	Casing Length (Ft.)
220	4"	210

Type of Casing	Hole Depth	Depth to Static Water Level
PVC	220	160

TYPE OF COMPLETION: (Circle One or More): (Gravel Packed) Underreamed, Telescoped, Natural Development, Open Hole, Other (Describe) ____

Top of Lap Pipe or Reduction in Casing FEET

IF TELESCOPED OR MORE THAN ONE SCREEN: USE BACK PAGE

LOG DATA

TYPE OF LOG RUN (Circle One): No Log Run, Electric, Gamma Ray, Density, Sonic, Neutron, Other (Describe) ____

Name of Organization Running Log:

GEOLOGIC DATA (Office Use Only)

Surface Elev.	Geologic Unit	Unit Thickness	Depth to Top
Subs. SWL	Date	Analysis	Aquifer Test

Driller's Remarks:

SCREEN DATA

Diameter - Inches	Length - Feet	Slot Size - Inches
4"	10'	013

Screen Type	Depth to Bottom - Feet
PVC	10'

DESCRIPTION OF FORMATIONS ENCOUNTERED	FROM	TO
RC	0	30
RC&S	30	80
Char-Sand	80	130
WS & C	130	180
WS	180	220

FORMATIONS (Continued)	FROM	TO

RECEIVED DEC 11 1989 Department of Natural Resources Bureau of Land & Water Resources

IF MORE SPACE IS NEEDED, USE BACK

If well telescopes please
sketch and show depths.

GROUND LEVEL

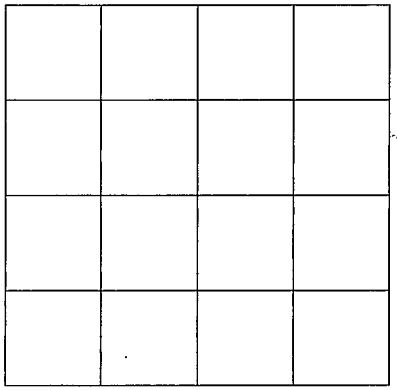

SECTION _____

Please indicate well location X.

ADDITIONAL INFORMATION

If more than one screen,
show location of each on sketch.