

MISSISSIPPI DEPARTMENT OF NATURAL RESOURCES

Bureau of Land and Water Resources

Southport Mall

P.O. Box 10631

Jackson, Mississippi 39209

WATER WELL DRILLERS LOG

PAOLA
NO. 385
C2001

HICKS WELL COMPANY

Paola

7-3 1985

RT. 6 Box 157

county well located

LANDOWNER: Abe Hill Jr.

SENA, MISS. description of formations encountered

from to

Ac # 2

Como MS 39819 (mailing address)

Red clay	0	10
Gravel & Red Sand	10	30
Black clay	30	90
White Sand & clay	90	110
White Sand	110	155

WELL LOCATION:

sec. 29 T 6 N R 7 E
 (S) (W)
 2 miles NW of Como
 (distance) (direction) (nearest town)

WELL PURPOSE: HOME
 (home, irrigation, municipal, industrial)


WELL COMPLETION DATA:

- (1) diameter (inches) 4"
- (2) total depth (feet) 155'
- (3) static water level (feet) 100' below top of ground.
- (4) casing PVC, 145' (depth)
 4" (size) if telescope see back.
- (5) screen 10' (length), 145' (depth to top)
 0.13 (size), PVC (material)
- (6) pump 1/2 (HP), 10 (yield gpm)
 220 V (type power)
- (7) electric log NO (yes or no)

(organization running log)

(8) how well bottom plugged Cap


DRILLERS REMARKS:

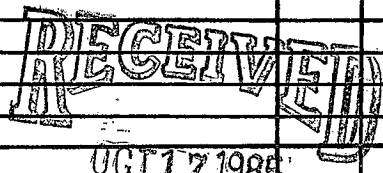

Department of Natural Resources
 Bureau of Land & Water Resources

If well telescopes please sketch and show depths.

GROUND LEVEL

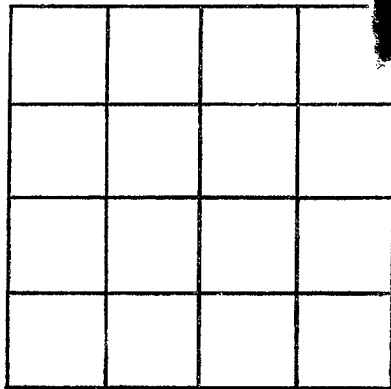

SECTION _____

Please indicate well location X.

ADDITIONAL INFORMATION

If more than one screen, show locations of each on sketch.