MISSISSIPPI DEPARTMENT OF ENVIRONMENTAL QUALITY
Office of Land and Water Resources

P. O. Box 10631
Jackson, MS 39289-0631

WATER WELL DRILLERS LOG

COUNTY WELL LOCATED: Panola	
WELL NUMBER: C 2052	CODED:
DATE WELL COMPLETED:	
PERMIT NUMBER:	
NAME OF DRILLING FIRM: N. Mi Well DR	
R. Langford	

NAME & MAILING ADDRESS OF LANDOWNER: Allen West, Hwy 310 W, Como MS

WELL LOCATION	SEC	TOWNSHIP	RANGE
	34	6 N (S)	7 E (W)

DISTANCE	DIRECTION	NEAREST TOWN
1 Miles	W of	Como

OTHER LANDMARK:

WELL PURPOSE (Home, Irrigation, Municipal, Industrial, Fish Pond, etc.): Food Store

PUMP DATA

PUMP TYPE (Circle One): Submersible, Turbine, Jet, Flowing Well, Other (Describe)

POWER TYPE (Circle One): Electric, Tractor, Diesel, Gasoline, Butane, Other (Describe) H/P 1½

Pump Capacity (GPM)	No of Stages	Setting Depth
20		140 FT.

PUMP TEST

Well yielded 30 GPM with a drawdown of 5 ft. after 1 hours of pumping

WELL DATA

Well Depth	Casing Diameter (In.)	Casing Length (Ft.)
150	4	20

Type of Casing	Hole Depth	Depth to Static Water Level
PVC	150	60 ft Top

TYPE OF COMPLETION: (Circle One or More): Gravel Packed, Underreamed, Telescoped, Natural Development, Open Hole, Other (Describe)

WELL GROUTED TO A DEPTH OF 10 FEET
Type Grout (circle one): Cement, Bentonite, or Mix

LOG DATA

TYPE OF LOG RUN (Circle One): No Log Run, Electric, Gamma Ray, Density, Sonic, Neutron, Other (Describe)

Name of Organization Running Log

GEOLOGIC DATA (Office Use Only)

Surface Elev	Geologic Unit	Unit Thickness	Depth to Top
Subs. SWL	Date	Analysis	Aquifer Test

Driller's Remarks

SCREEN DATA

Diameter - Inches	Length - Feet	Slot Size - Inches
4	10	.013

Screen Type	Depth to Bottom - Feet
PVC	150

Top of Lap Pipe or Reduction in Casing: FEET

IF TELESCOPED OR MORE THAN ONE SCREEN: USE BACK PAGE

DESCRIPTION OF FORMATIONS ENCOUNTERED	FROM	TO
DIRT	0	20
SAND	20	40
WHT SAND / GRAVEL	40	60
GRAVEL	60	100
W/ CLAY	100	120
W/ SAND	120	150

FORMATIONS (Continued)	FROM	TO
IF MORE SPACE IS NEEDED, USE BACK		

RECD JUN 11 2001

If well telescopes please sketch and show depths.

GROUND LEVEL

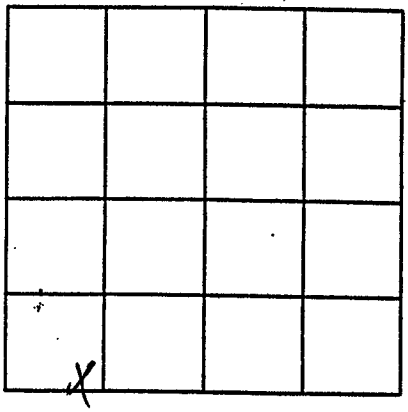

SECTION 34

Please indicate well location X.

ADDITIONAL INFORMATION

If more than one screen,