PANOLA
D 2009
8-5-77

156

MISSISSIPPI
BOARD OF WATER COMMISSIONERS
416 North State Street
Jackson, Mississippi 39201

WATER WELL DRILLERS LOG

8-5-77 19 Earnest Pratcher Panola
date well completed — firm name — county well located

LANDOWNER: Earnest Pratcher
RT. 1 Como Miss
(mailing address)

WELL LOCATION:
sec 26 T 7 N(S) 6 R 6 E(W)
7 miles N E of Como
(distance) (direction) (nearest town)

WELL PURPOSE: Home
(home, irrigation, municipal, industrial)

WELL COMPLETION DATA:

(1) diameter (inches) 4"
(2) total depth (feet) 150
(3) static water level (feet) 120 below above top of ground.
(4) casing PVC (material), 143 (depth),
_____ (size) if telescope see back.
(5) screen 7' (length), 7' (depth to top)
4" (size), mesh Rock (material)
(6) pump 1/2 (HP) 10 (yield gpm)
Elect (type power)
(7) electric log _____ (yes or no)
_____ (organization running log)
(8) how well bottom plugged Cap

DRILLERS REMARKS:

description of formations encountered	from	to
RC	0	20
RC & S	20	120
W S	120	150

RECEIVED
AUG 18 1977
MISS. BD. OF WATER COMM.

If well telescopes please sketch and show depths.

GROUND LEVEL

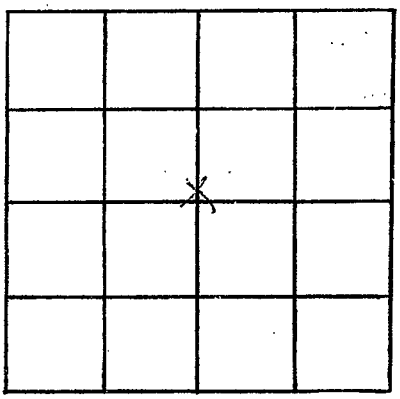

SECTION _____

Please indicate well location X.

ADDITIONAL INFORMATION

If more than one screen, show locations of each on sketch.