# MISSISSIPPI DEPARTMENT OF NATURAL RESOURCES

Bureau of Land and Water Resources

P.O. Box 10631
Jackson, Mississippi 39209
WATER WELL DRILLERS LOG

| | |
|---|---|
| COUNTY WELL LOCATED: Panola | |
| WELL NUMBER: D 2088 | CODED |
| DATE WELL COMPLETED: 8-13-88 | |
| PERMIT NUMBER | |
| NAME OF DRILLING FIRM: HICKS WELL COMPANY | |
| RT. 1 - BOX 157 SENATOBIA, MISS. | |

NAME & MAILING ADDRESS OF LANDOWNER:
Raymond Walker
Rt. 1
Como, Ms. 38619

WELL LOCATION: SEC 35 TOWNSHIP 6 N (S) RANGE 6 E (W)

DISTANCE 3 Miles DIRECTION SW of NEAREST TOWN Sledmville

OTHER LANDMARK

WELL PURPOSE: (Home) Irrigation, Municipal, Industrial, Fish Pond, etc.

## PUMP DATA

PUMP TYPE (Circle One): (Submersible), Turbine, Jet, Flowing Well, Other (Describe) ____

POWER TYPE (Circle One): (Electric), Tractor, Diesel, Gasoline, Butane, Other (Describe) ____

| Pump Capacity (GPM) | No. of Stages | Setting Depth |
|---|---|---|
| 10 | 12 | FT. |

PUMP TEST

Well yielded ____ GPM with a drawdown of ____ ft. after ____ hours of pumping

## WELL DATA

| Well Depth | Casing Diameter (In.) | Casing Length (Ft.) |
|---|---|---|
| 240 | 4 | 230 |

| Type of Casing | Hole Depth | Depth to Static Water Level |
|---|---|---|
| PVC | 240 | 170 |

TYPE OF COMPLETION: (Circle One or More): Gravel Packed, Underreamed, Telescoped, (Natural Development), Open Hole, Other (Describe) ____

Top of Lap Pipe or Reduction in Casing FEET

IF TELESCOPED OR MORE THAN ONE SCREEN: USE BACK PAGE

## SCREEN DATA

| Diameter - Inches | Length - Feet | Slot Size - Inches |
|---|---|---|
| 4 | 10 | .013 |

| Screen Type | Depth to Bottom - Feet |
|---|---|
| PVC | 0 |

## LOG DATA

TYPE OF LOG RUN (Circle One): (No Log Run), Electric, Gamma Ray, Density, Sonic, Neutron, Other (Describe) ____

Name of Organization Running Log

## GEOLOGIC DATA (Office Use Only)

| Surface Elev. | Geologic Unit | Unit Thickness | Depth to Top |
|---|---|---|---|
| Subs. SWL | Date | Analysis | Aquifer Test |

Driller's Remarks

RECEIVED
SEP 14 1988
Department of Natural Resources
Bureau of Land & Water Resources

| DESCRIPTION OF FORMATIONS ENCOUNTERED | FROM | TO |
|---|---|---|
| Red Clay | 0 | 15 |
| Red Sand | 15 | 30 |
| White Clay + Sand | 30 | 120 |
| White Sand | 120 | 240 |

| FORMATIONS (Continued) | FROM | TO |
|---|---|---|
| | | |

IF MORE SPACE IS NEEDED, USE BACK

If well telescopes please
sketch and show depths.

GROUND LEVEL

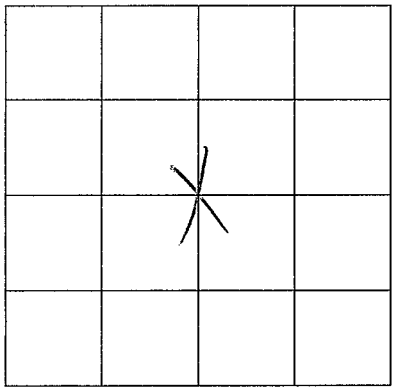

SECTION 35

Please indicate well location X.

ADDITIONAL INFORMATION

If more than one screen,
show location of each on sketch.